IREDELL COUNTY HEALTH DEPARTMENT

STATESVILLE 704-878-5305 CI MOORESVILLE 704-664-5281

IMPROVEMENT PERMIT / AUTHORIZATION TO CONSTRUCT / OPERATION PERMIT / EXISTING SYSTEM INSPECTION

PERMIT# 105441 PIN# 4727-81-2803 DATE 6-24-02

OWNER OR CONTRACTOR FOY-WHITE PARTNERSHIP PHONE: Business 704-872-0072 Home

ADDRESS P.O. BOX 5671, STATESVILLE, NC 28687

LOCATION NC 115 N, TR RED CHIMNEY RD, TR FOY LANE, 6TH LOT ON RIGHT

SUBDIVISION NORTH CROSSING BLOCK / SECTION LOT 30' LOT AREA 0.433 ACRE SITE CLASS. PS DESIGN FLOW 360 L.T.A.R. 0.30 GPD/FT²

Septic Tank: 1000 Gallons; STB 1007 Date 4-1-04

Pump Tank: Gallons; PT Date

Pump Make: Model Serial No.

Nitrification Field: No Fields 1 Square Feet EQ. TO 1200 Linear Feet 200

No Lines SIX Trench Width 24" Max Trench Bottom Depth 36" Gravel Depth 12"

☑ New System ☐ Repair System Type: I, II, III, IV, V, VI

System Description: 50% REDUCTION GRAVITY

Repair System Description: 50% REDUCTION GRAVITY

Maintenance Agreement Required: ☐ Yes ☑ No

☑ House/Mod. Home No. Bedrooms 3

☐ Mobile Home No. Bathrooms 2

☐ Business No. Employees

☐ Other


☐ Slab ☑ Crawl Space ☐ Basement w/plumbing ☐ Basement wo/plumbing

Water Supply: ☐ Individual ☑ Public ☐ Community

Comments/Conditions: INSTALL 50% REDUCTION SYSTEM USING 48 PPBPS PANELS IN SIX EQUAL LENGTH LINES

Comments/Conditions: - Tuff-Tite Effort ST marker

INITIAL SITE SKETCH

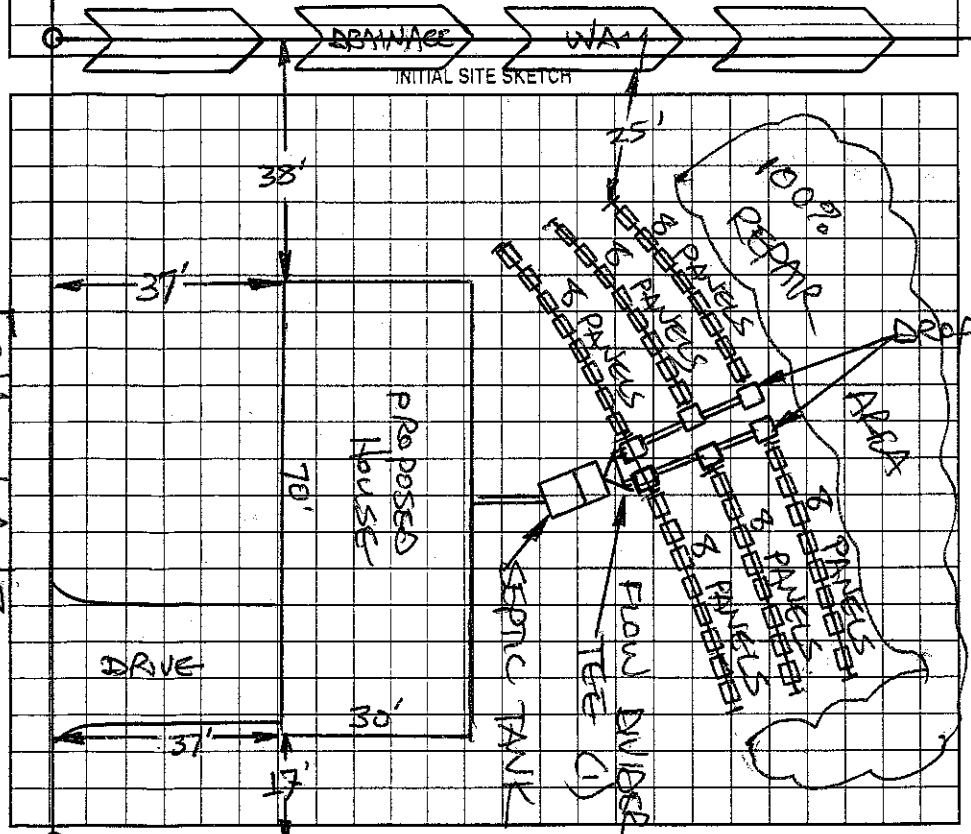

AS BUILT SKETCH

Installed AS Shown per Initial Site Sketch

Permit can be suspended or revoked if any false information is supplied toward securing the permit/any unauthorized changes are made to the site/any unauthorized changes are made in the installation of the system. Improvement Permit with plat valid without expiration. Improvement Permit with site plan valid for sixty months. Authorization to Construct is valid for a period equal to that of Improvement Permit – not to exceed sixty months.

Signed: Margaret B. White date 7-18-02 Installed by: Tommy Colbert + Son

Improvement Permit by: STEVE HENDRICK date 6-24-02 Operation Permit by: William O Johnson date 5/11/04

Authorization to Construct by: STEVE HENDRICK date 6-24-02 Existing System Inspection by: date

HEALTH DEPT. COPY: WHITE OWNER COPY (FINAL): YELLOW OWNER COPY (INITIAL): PINK