IREDELL COUNTY HEALTH DEPARTMENT

STATESVILLE 704-878-5305 CV MOORESVILLE 704-664-5281

IMPROVEMENT PERMIT / AUTHORIZATION TO CONSTRUCT / OPERATION PERMIT / EXISTING SYSTEM INSPECTION

PERMIT# 105536 PIN# 4727 81 4851 DATE 7/27/05

OWNER OR CONTRACTOR THOMAS J & MARGARET WHITE PHONE: Business 704-902-9182 Home

ADDRESS 517 STINSON CT STATESVILLE, NC 28677

LOCATION 115 N (R) RED CHIMNEY RD (R) FOY LN (L) Lot 137 FOY LN

SUBDIVISION NORTH CROSSING BLOCK / SECTION LOT 10 LOT AREA .52 ACRES SITE CLASS. PS DESIGN FLOW 360 gpd L.T.A.R. .3

Septic Tank: 1000 Gallons; STB ~~#225~~ Date 10-28-05

Pump Tank: Gallons; PT Date

Pump Make: Model Serial No.

Nitrification Field: No Fields 1 Square Feet 1200 Linear Feet 300

No Lines 3 Trench Width 36" Max Trench Bottom Depth 36" Gravel Depth NA

[X] New System [ ] Repair System Type: I, II, III, IV, V, VI

System Description: GRAVITY 25% REDUCTION

Repair System Description: GRAVITY 25% REDUCTION

Maintenance Agreement Required: [ ] Yes [X] No

[X] House/Mod. Home No. Bedrooms 3

[ ] Mobile Home No. Bathrooms 2

[ ] Business No. Employees

[ ] Other


[ ] Slab [X] Crawl Space [ ] Basement w/plumbing [ ] Basement wo/plumbing

Water Supply: [ ] Individual [X] Public [ ] Community

Comments/Conditions: USE EFFLUENT SPLITTER SUCH AS ZOELLER TRU-FLO

SCALE: 1" = 50'

INITIAL SITE SKETCH

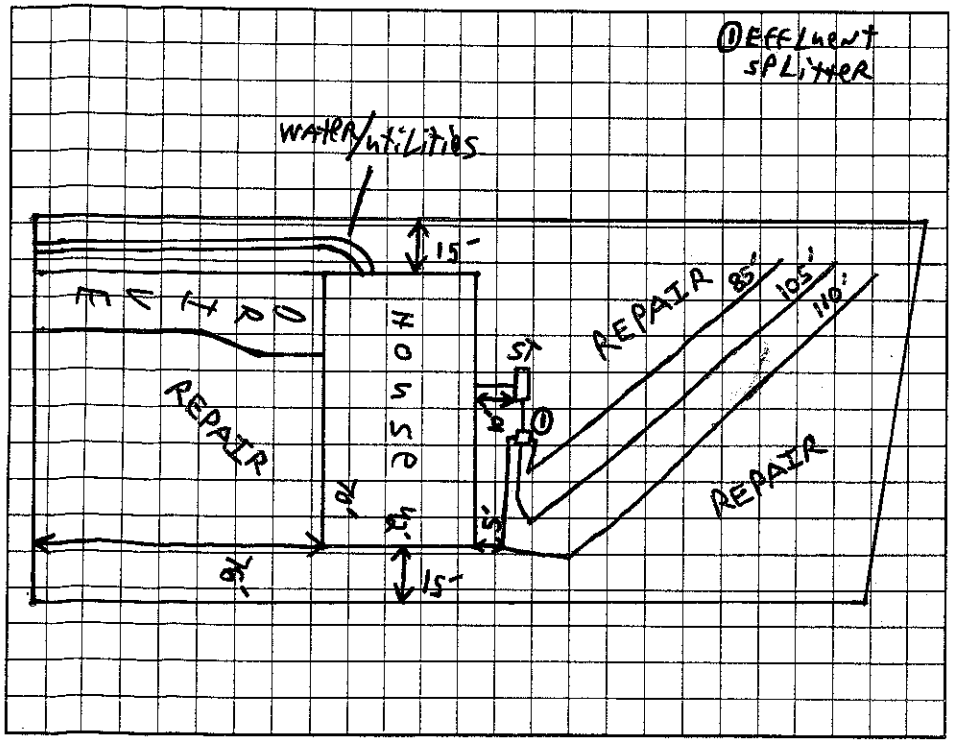

Comments/Conditions: BLUE TUFF TANK FILLER 75 Q-4 INSPECTOR CHAMBER

AS BUILT SKETCH

Permit can be suspended or revoked if any false information is supplied toward securing the permit/any unauthorized changes are made to the site/any unauthorized changes are made in the installation of the system. Improvement Permit with plat valid without expiration. Improvement Permit with site plan valid for sixty months. Authorization to Construct is valid for a period equal to that of Improvement Permit – not to exceed sixty months.

Signed: Lisa C. Williams date 8-15-05 Installed by: Kenny Madison

Improvement Permit by: Elaine Marie Q date 7/27/05 Operation Permit by: Kelly Cook date 1-9-06

Authorization to Construct by: Elaine Marie Q date 7/27/05 Existing System Inspection by: date

HEALTH DEPT. COPY: WHITE OWNER COPY (FINAL): YELLOW OWNER COPY (INITIAL): PINK