IREDELL COUNTY HEALTH DEPARTMENT

STATESVILLE 704-878-5305 MOORESVILLE 704-664-5281

IMPROVEMENT PERMIT / AUTHORIZATION TO CONSTRUCT / OPERATION PERMIT / EXISTING SYSTEM INSPECTION

CI

PERMIT# 105537 PIN# 4727-81-4930 DATE Sept. 27, 02

OWNER OR CONTRACTOR Foy- White Partnership PHONE: Business Home

ADDRESS P.O. Box 5671 Statesville, N.C. 28687

LOCATION 115 N. TR Red Chimney TR Foy on left

SUBDIVISION North Crossing BLOCK / SECTION II LOT 9 LOT AREA .557 Ac SITE CLASS. PS DESIGN FLOW 360gpd L.T.A.R. .3

Septic Tank: 1000 Gallons; STB 1092 Date 10-30-02
Pump Tank: Gallons; PT Date
Pump Make: Model Serial No.
Nitrification Field: No Fields 1 Square Feet 1200 Linear Feet 400
No Lines 5 Trench Width 36" Max Trench Bottom Depth 36"

☑ New System ☐ Repair System Type: I (II) III IV V VI
System Description: Gravity conventional
Repair System Description: 50% Reduction
Maintenance Agreement Required: ☐ Yes ☑ No

☑ House/Mod. Home No. Bedrooms 3
☐ Mobile Home No. Bathrooms 2
☐ Business No. Employees
☐ Other


Gravel Depth 12" ☐ Slab ☑ Crawl Space ☐ Basement w/plumbing ☐ Basement wo/plumbing

Water Supply: ☐ Individual ☑ Public ☐ Community


Comments:/Conditions:

Comments:/Conditions: 4X75 INSTALLED QUICK 4 TUFFTITE FILTER + MARKER

1"=50' INITIAL SITE SKETCH

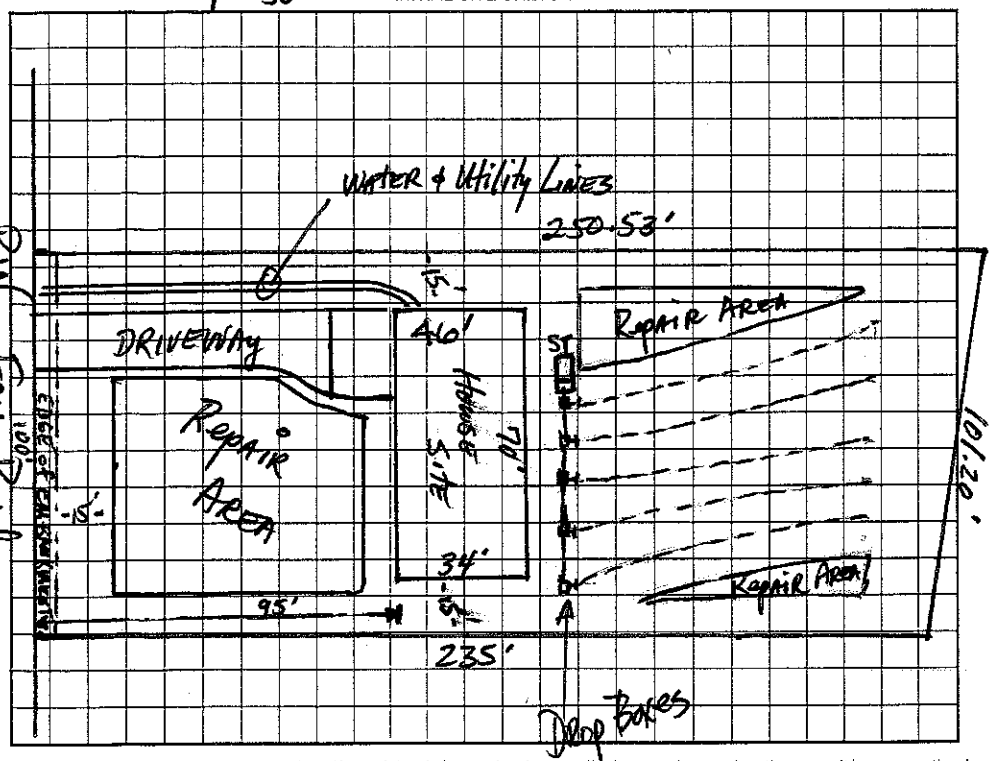

AS BUILT SKETCH

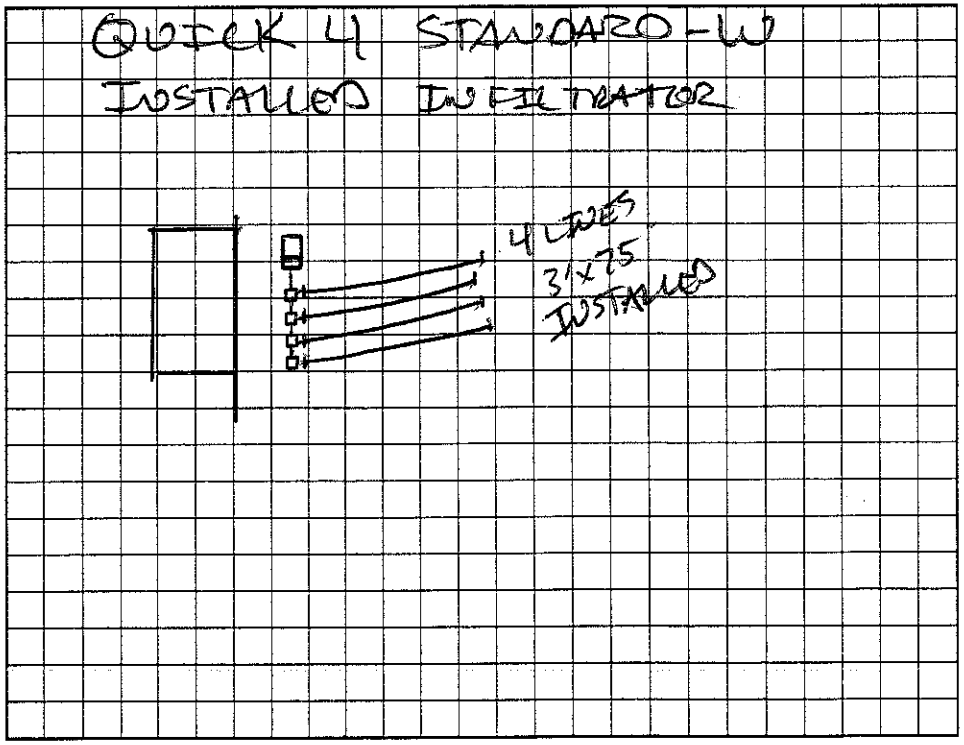

Permit can be suspended or revoked if any false information is supplied toward securing the permit/any unauthorized changes are made to the site/any unauthorized changes are made in the installation of the system. Improvement Permit with plat valid without expiration. Improvement Permit with site plan valid for sixty months. Authorization to Construct is valid for a period equal to that of Improvement Permit – not to exceed sixty months.

Signed: date 11/7/02 Installed by: STEVE JORDAN

Improvement Permit by: date 9-27-02 Operation Permit by: date 5-9-05

Authorization to Construct by: STEVE HEDRICK date 11-9-04 Existing System Inspection by: date

HEALTH DEPT. COPY: WHITE OWNER COPY (FINAL): YELLOW OWNER COPY (INITIAL): PINK