IREDELL COUNTY HEALTH DEPARTMENT

STATESVILLE 704-878-5305 (CI) MOORESVILLE 704-664-5281

IMPROVEMENT PERMIT / AUTHORIZATION TO CONSTRUCT / OPERATION PERMIT / EXISTING SYSTEM INSPECTION

PERMIT# 105529/141914 PIN# 4727-81-5084 DATE Oct 16, 02

OWNER OR CONTRACTOR Foyt White Partnership PHONE: Business _____ Home _____

ADDRESS P.O. Box 5671 Statesville N.C. 28625

LOCATION 115 N TR Red Chimney TR Foy Lane on left

SUBDIVISION North Crossing BLOCK / SECTION 2 LOT 17 LOT AREA .53ac SITE CLASS. PS DESIGN FLOW 360gpd L.T.A.R. no. 3

Septic Tank: 1000 Gallons; STB 760 Date 1-23-07

Pump Tank: _____ Gallons; PT _____ Date _____

Pump Make: _____ Model _____ Serial No. _____

Nitrification Field: No Fields ___ Square Feet 960 Linear Feet 320

No Lines 4@80' Trench Width 36" Max Trench Bottom Depth 36" Gravel Depth N/A

☒ New System ☐ Repair System Type: I, II, III, IV, V, VI

System Description: Gravity 25% Reduction

Repair System Description: Pumped 25% Reduction

Maintenance Agreement Required: ☐ Yes ☒ No

☒ House/Mod. Home No. Bedrooms 3

☐ Mobile Home No. Bathrooms 2

☐ Business No. Employees ___

☐ Other _____

☐ Slab ☒ Crawl Space ☐ Basement w/plumbing ☐ Basement wo/plumbing

Water Supply: ☐ Individual ☒ Public ☐ Community


Comments:/Conditions:

Comments:/Conditions:

Black Filter

INITIAL SITE SKETCH

1"=50'

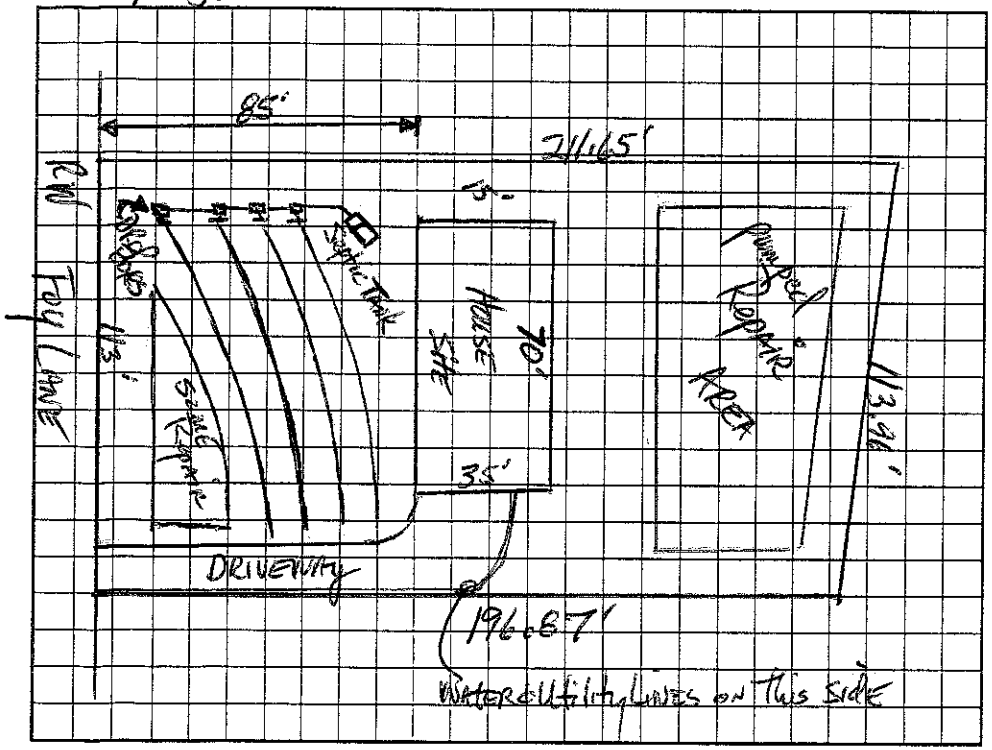

AS BUILT SKETCH

Permit can be suspended or revoked if any false information is supplied toward securing the permit/any unauthorized changes are made to the site/any unauthorized changes are made in the installation of the system. Improvement Permit with plat valid without expiration. Improvement Permit with site plan valid for sixty months. Authorization to Construct is valid for a period equal to that of Improvement Permit – not to exceed sixty months.

Signed: _____ date 11/7/02 Installed by: Madison Grading

Improvement Permit by: _____ date 10-16-02 Operation Permit by: _____ date 5-24-07

Authorization to Construct by: _____ date 4-3-07 Existing System Inspection by: _____ date _____

HEALTH DEPT. COPY: WHITE OWNER COPY (FINAL): YELLOW OWNER COPY (INITIAL): PINK