IREDELL COUNTY HEALTH DEPARTMENT

THIS PERMIT REPLACES PREVIOUS ISSUED 10/29/2002

STATESVILLE 704-878-5305 MOORESVILLE 704-664-5281

IMPROVEMENT PERMIT / AUTHORIZATION TO CONSTRUCT / OPERATION PERMIT / EXISTING SYSTEM INSPECTION

PERMIT# 105530 PIN# 4727-81-5186 DATE 3-31-2006

OWNER OR CONTRACTOR CUSTOM HOMES BY LISA, INC PHONE: Business 704-902-0733 Home

ADDRESS 220 CROSS COUNTRY ROAD STATESVILLE NC 28625

LOCATION NC 115 N. TR RED CHIMNEY RD, TR FOY LANE, LOT ON LEFT AT BOX # 169

SUBDIVISION NORTH CROSSING BLOCK / SECTION II LOT 16' LOT AREA 0.57 ACRE' SITE CLASS. PS DESIGN FLOW 360 L.T.A.R. 0.30 GAD/FT2

Septic Tank: 1000 Gallons; STB TP-SID Date 2-31-06

Pump Tank: Gallons; PT 1012-100 Date

Pump Make: Model Serial No.

Nitrification Field: No Fields 1 Square Feet ED.P 1200 Linear Feet 400

No Lines FIVE Trench Width 36" Max Trench Bottom Depth 36" Gravel Depth 12"

☑ New System ☐ Repair System Type: I, II, III, IV, V, VI

System Description: CONVENTIONAL GRAVITY

Repair System Description: 25% REDUCTION, PUMP

Maintenance Agreement Required: ☐ Yes ☑ No

☑ House/Mod. Home No. Bedrooms 3

☐ Mobile Home No. Bathrooms

☐ Business No. Employees

☐ Other


☐ Slab ☑ Crawl Space ☐ Basement w/plumbing ☐ Basement wo/plumbing

Water Supply: ☐ Individual ☑ Public ☐ Community


Comments:/Conditions: ① AN "ACCEPTED" SYSTEM MAY ALSO BE USED ② SIDE ENTRY GARAGE ③ WATER LINE TO BE LOCATED ON RIGHT PROPERTY LINE.

Comments:/Conditions: Installed as Infiltrator Rock 4

INITIAL SITE SKETCH

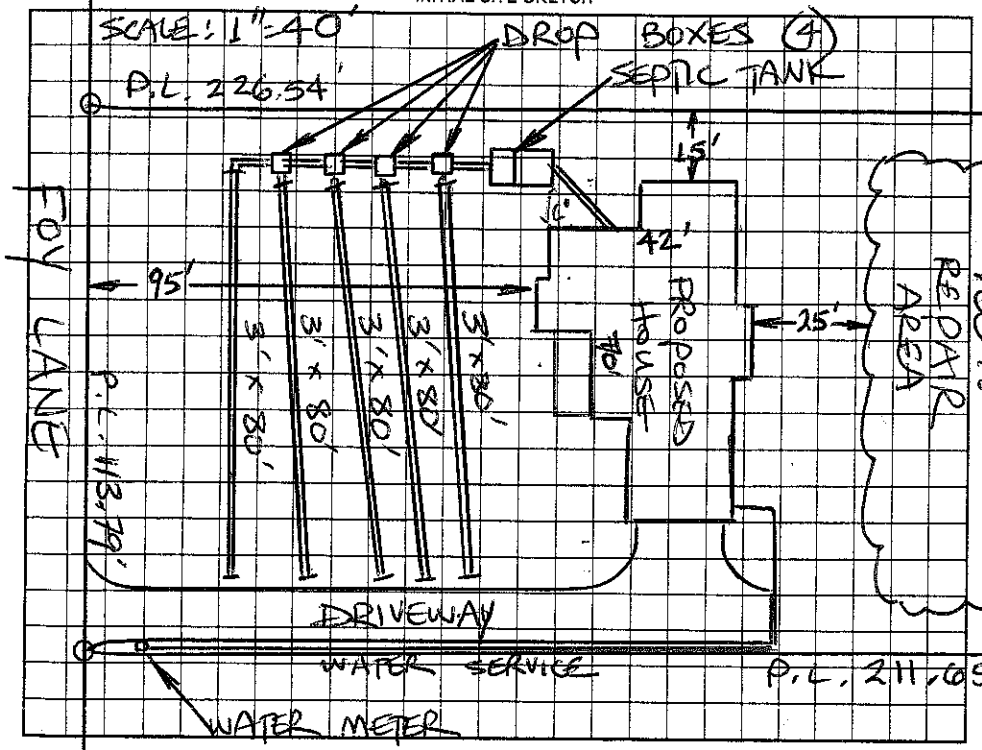

AS BUILT SKETCH

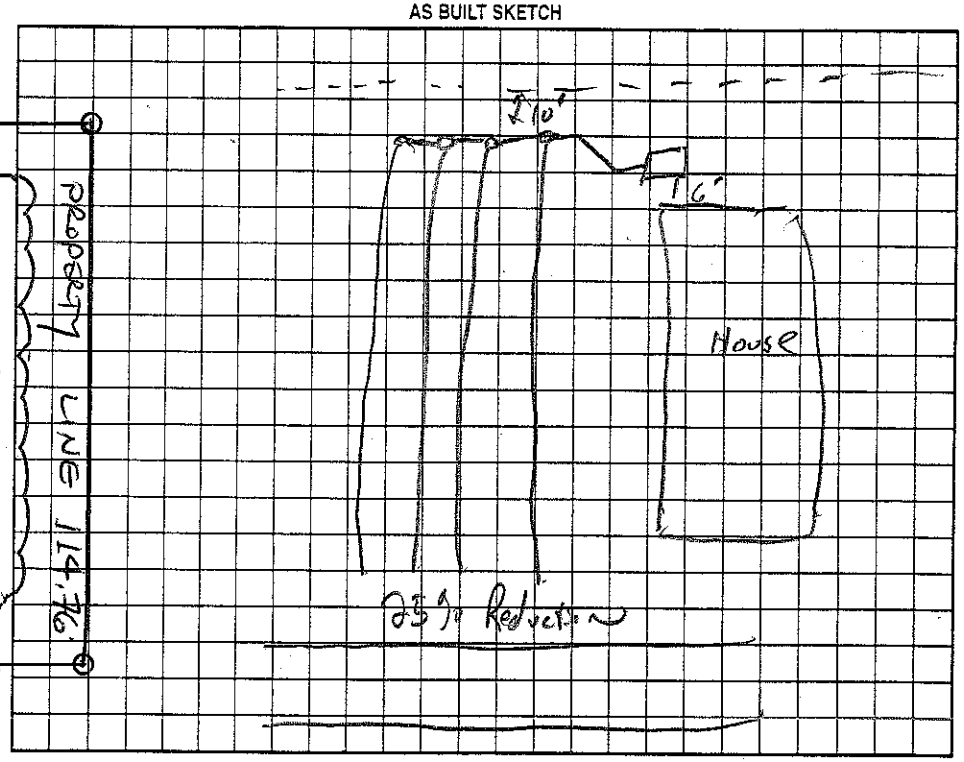

Permit can be suspended or revoked if any false information is supplied toward securing the permit/any unauthorized changes are made to the site/any unauthorized changes are made in the installation of the system. Improvement Permit with plat valid without expiration. Improvement Permit with site plan valid for sixty months. Authorization to Construct is valid for a period equal to that of Improvement Permit – not to exceed sixty months.

Signed: Lisa C. Williams date 4-4-06 Installed by: Steve Hedrick

Improvement Permit by: STEVE HEDRICK date 3-31-2006 Operation Permit by: [signature], R.S. date 6 Oct 06

Authorization to Construct by: STEVE HEDRICK date 3-31-2006 Existing System Inspection by: date

HEALTH DEPT. COPY: WHITE OWNER COPY (FINAL): YELLOW OWNER COPY (INITIAL): PINK