# IREDELL COUNTY HEALTH DEPARTMENT

STATESVILLE 704-878-5305 (2) MOORESVILLE 704-664-5281

## IMPROVEMENT PERMIT / AUTHORIZATION TO CONSTRUCT / OPERATION PERMIT / EXISTING SYSTEM INSPECTION

PERMIT# 124975 PIN# 4727-82-2486 DATE 12-7-04

OWNER OR CONTRACTOR HAYDEN HAMBY JR PHONE: Business _____ Home 704-872-0825

ADDRESS 906 OLD MOCKSVILLE ROAD, STATESVILLE NC 28625

LOCATION NC 115 NORTH, TR RED CHIMNEY ROAD, 1ST LOT ON RIGHT PAST FOY LANE

SUBDIVISION ~~IRMA ACRES~~ IRMA ACRES BLOCK / SECTION I LOT 8 LOT AREA 0.67 ACRE SITE CLASS. PS DESIGN FLOW 360 L.T.A.R. 0.30 GPD/FT2

IRMA ACRES

Septic Tank: 1000 Gallons; STB 1007 Date 4-11-05

Pump Tank: _____ Gallons; PT _____ Date _____

Pump Make: _____ Model _____ Serial No. _____

Nitrification Field: No Fields 1 Square Feet 1200 Linear Feet 400

No Lines FOUR Trench Width 36" Max Trench Bottom Depth 36" Gravel Depth 12"

☑ New System ☐ Repair System Type: I, II, III, IV, V, VI

System Description: CONVENTIONAL, GRAVITY

Repair System Description: 25% REDUCTION, PUMP

Maintenance Agreement Required: ☐ Yes ☐ No

☑ House/Mod. Home No. Bedrooms 3

☐ Mobile Home No. Bathrooms ____

☐ Business No. Employees ____

☐ Other _____


☐ Slab ☑ Crawl Space ☐ Basement w/plumbing ☐ Basement wo/plumbing

Water Supply: ☐ Individual ☑ Public ☐ Community


Comments/Conditions: INSTALL DRAINLINES ON CONTOUR AS FLAGGED

Comments/Conditions: SEPTIC TANK W/ MARKER INSTALLED USING "FABEC" FILTER

INITIAL SITE SKETCH

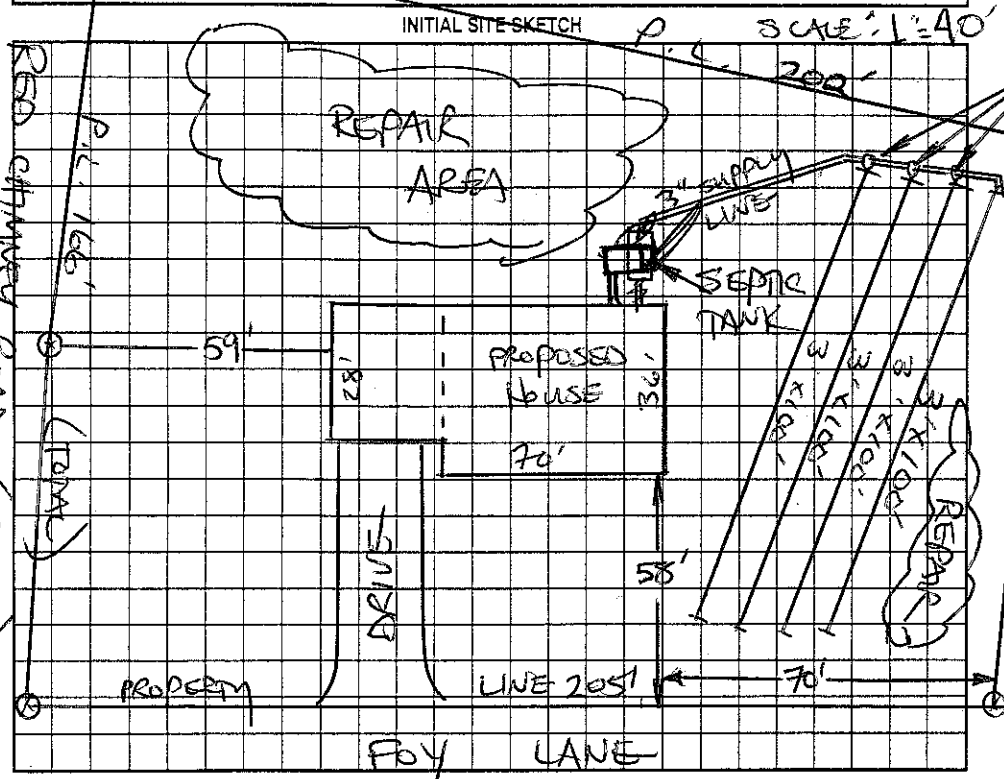


AS BUILT SKETCH

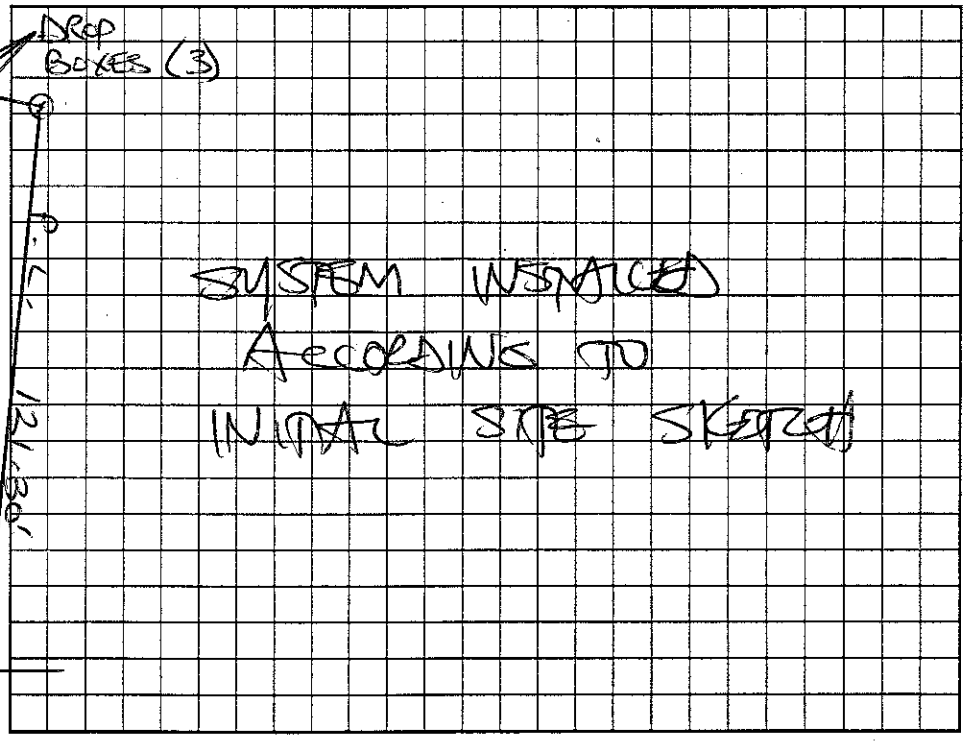


Permit can be suspended or revoked if any false information is supplied toward securing the permit/any unauthorized changes are made to the site/any unauthorized changes are made in the installation of the system. Improvement Permit with plat valid without expiration. Improvement Permit with site plan valid for sixty months. Authorization to Construct is valid for a period equal to that of Improvement Permit – not to exceed sixty months.

Signed: X Hayden Hamby JR date 12-7-04

Improvement Permit by: STEVE HEDRICK date 12-7-04

Authorization to Construct by: STEVE HEDRICK date 12-7-04

Installed by: TERRY COOKE

Operation Permit by: STEVE HEDRICK date 6-9-05

Existing System Inspection by: _____ date _____

HEALTH DEPT. COPY: WHITE OWNER COPY (FINAL): YELLOW OWNER COPY (INITIAL): PINK