IREDELL COUNTY HEALTH DEPARTMENT

Statesville Office (704) 878-5305 Mooresville Office (704) 660-3625 PERMIT # 176978

IMPROVEMENT PERMIT / AUTHORIZATION TO CONSTRUCT / OPERATION PERMIT / EXISTING SYSTEM

PIN # 4727823099

APPLICANT: Harry & Lorraine Curtis APPLICANT ADDRESS: 125 Foy Lane

SITE ADDRESS: 125 Foy Lane PHONE: 704 876 3080 ALT. PHONE:

SITE DIRECTIONS: 115 N, (R) on Red Chimney (R) on Foy Lane, 4th lot on left

SUBDIVISION: North Crossing SECTION: LOT # 7 LOT AREA: .613 DESIGN FLOW: 360 L.T.A.R.: .3

Septic Tank Ex. (gal) STB Ex Date Ex

Pump Tank (gal) PT Date

Pump Make Model Serial #

Nitrification Fields 1 # Lines 5 Linear Ft: 300

Trench Width Ex Max. Trench Bottom Depth Ex Gravel Depth 0 N/A

☐ New System ☐ Repair ☐ Expansion System Type: I II (III) IV V VI

System Description: Existing 25% Reduction Gravity

Repair System Description: Pump 25% Reduction

Maintenance Agreement Required: ☐ YES ☒ NO

☒ GRAVITY ☐ PRESSURE

☒ Residence No. Bedrooms 3

☐ Business No. Persons

☐ Other No. Employees

☐ Slab ☒ Crawl Space

☐ Basement w/plumbing ☐ Basement w/o plumbing

Water Supply


☐ Private

☒ Public


☐ Community

Comments / Conditions:

INITIAL SITE SKETCH

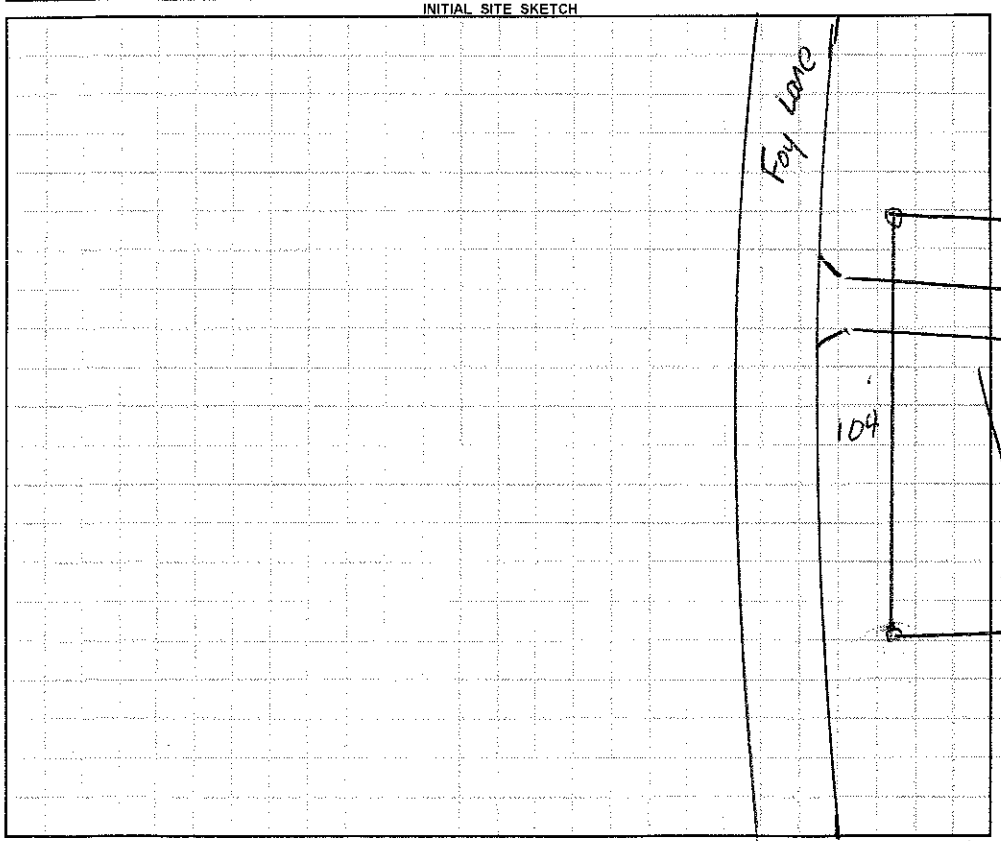

AS BUILT SKETCH

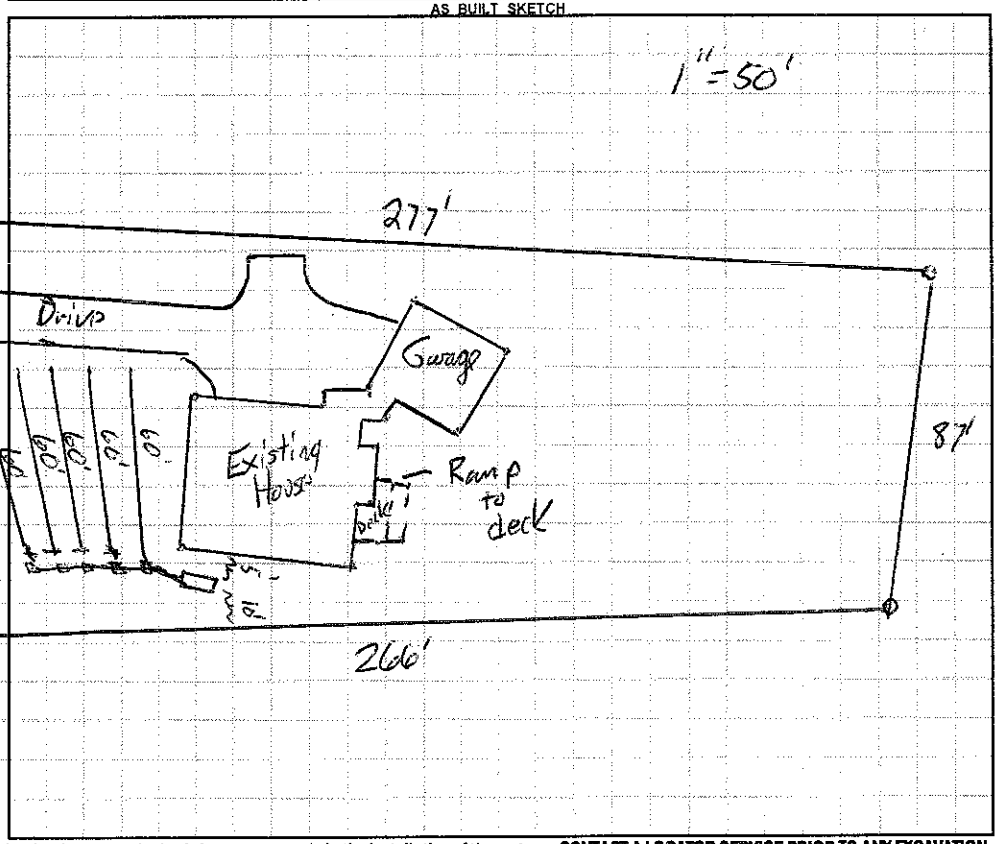

Permit can be suspended or revoked if any false information is supplied toward securing the permit / any unauthorized changes are made to the site / any unauthorized changes are made in the installation of the system. **CONTACT A LOCATOR SERVICE PRIOR TO ANY EXCAVATION**

☐ **IMPROVEMENT PERMIT *with plat*** *valid without expiration* ☐ **IMPROVEMENT PERMIT *with site plan*** *valid for 60 mos.* ☐ **AUTHORIZATION TO CONSTRUCT** *valid for period equal to IMPROVEMENT PERMIT--not to exceed 60 mo.*

Owner / Applicant Signature: Harry & Curtis Date: 5/8/13 Installed by:

IMPROVEMENT PERMIT by: Date: OPERATION PERMIT by: Date:

AUTHORIZATION TO CONSTRUCT by: Date: Existing System Inspected by: James Date: 2-8-13

Health Dept. Copy - WHITE Applicant (Final Approval) - YELLOW Applicant (Conditional Approval) - PINK