IREDELL COUNTY HEALTH DEPARTMENT

STATESVILLE 704-878-5305 (I) MOORESVILLE 704-664-5281

IMPROVEMENT PERMIT / AUTHORIZATION TO CONSTRUCT / OPERATION PERMIT / EXISTING SYSTEM INSPECTION

PERMIT# 13462 PIN# 4727~~78088~~ 8606667 DATE 4-12-06

OWNER OR APPLICANT Clayton Homes PHONE: Business 704-873-2547 Home

ADDRESS Yadkin Valley Rd

LOCATION Hwy 115 N (R) Yadkin Valley Rd. property on left

SUBDIVISION n/a BLOCK / SECTION LOT ~~lot~~ LOT AREA 10+ Acres SITE CLASS. PS DESIGN FLOW ~~480~~ 360 L.T.A.R. .3

Septic Tank: 1000 Gallons; STB 1012 Date 11-1-05
Pump Tank: Gallons; PT Date
Pump Make: Model Serial No. 300 ~~400~~
Nitrification Field: No Fields 1 Square Feet 1600 Linear Feet ~~400~~ 300
No Lines 4 Trench Width 36" Max Trench Bottom Depth 36"

☒ New System ☐ Repair ☐ Expansion System Type: I (II) III IV V VI
System Description: 25% Reduction
Repair System Description: 25% Reduction
Maintenance Agreement Required: ☐ Yes ☒ No

☒ House/Mod. Home No. Bedrooms ~~4~~ 3
☐ Mobile Home No. Persons
☐ Business No. Employees
☐ Other


Water Supply: ☒ Individual ☐ Public ☐ Community

Gravel Depth n/a ☐ Gravity ☐ Pressure ☐ Slab ☒ Crawl Space ☐ Basement w/plumbing ☐ Basement wo/plumbing

Comments:/Conditions:

Comments:/Conditions:

INITIAL SITE SKETCH

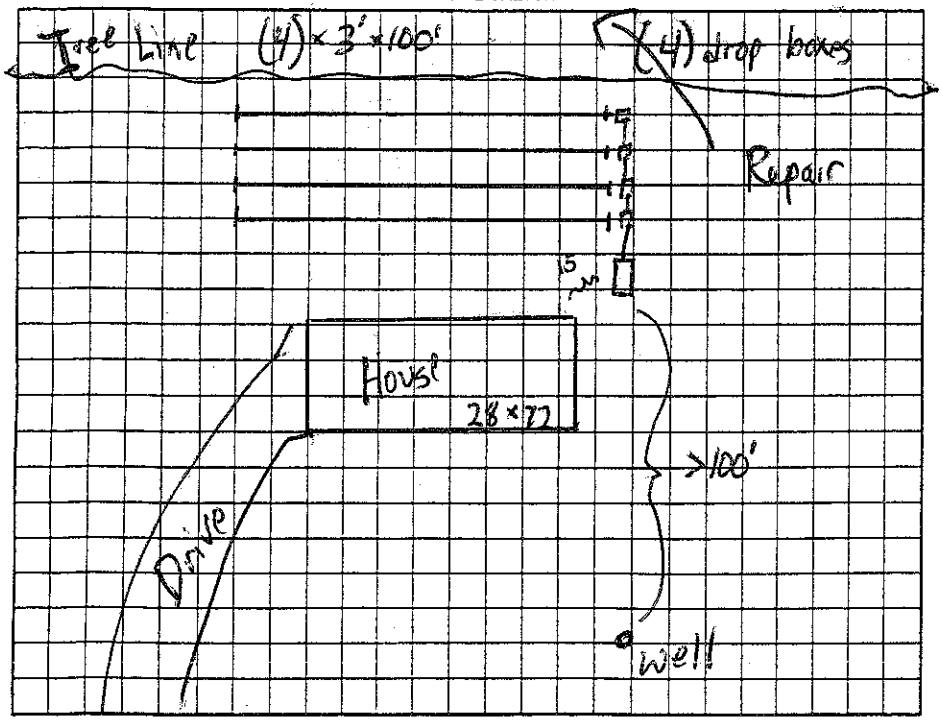

AS BUILT SKETCH

Permit can be suspended or revoked if any false information is supplied toward securing the permit/any unauthorized changes are made to the site/any unauthorized changes are made in the installation of the system. Improvement Permit with plat valid without expiration. ☐ Improvement Permit with site plan valid for sixty months ☐ Authorization to Construct is valid for a period equal to that of Improvement Permit – not to exceed sixty months.

Signed: date 4/13/06 Installed by: A-1 Backhoe

Improvement Permit by: James date 4-13-06 Operation Permit by: James date 5-31-06

Authorization to Construct by: James date 4-13-06 Existing System Inspection by: date

HEALTH DEPT. COPY: WHITE OWNER COPY (FINAL): YELLOW OWNER COPY (INITIAL): PINK