3:30

IREDELL COUNTY HEALTH DEPARTMENT - *ENVIRONMENTAL HEALTH* ☑ STATESVILLE OFFICE 704-878-5305 ☐ MOORESVILLE OFFICE 704-664-5281

IMPROVEMENT PERMIT / AUTHORIZATION TO CONSTRUCT / OPERATION PERMIT / EXISTING SYSTEM INSPECTION

PERMIT # 172065 PIN # 4727886252 DATE 6-18-12

OWNER ZMH Statesville LLC APPLICANT: Scott McCoy PHONE: Home/Cell # 704-239-3693 Business # N/A

SITE ADDRESS Yadkin Valley Rd. Statesville OWNER / APPLICANT ADDRESS 226 W. Bingham Ave. Statesville NC

SITE DIRECTIONS HWY 115 N; R on Yadkin Valley Rd. ; Property on Right

SUBDIVISION Deer Creek Meadows BLOCK / SECTION N/A LOT # #2 LOT AREA 3.44 acres DESIGN FLOW 480 gpd L.T.A.R. 0.25

Septic Tank 1000 Gallons: STB 1012 Date 12-5-11

Pump Tank ____ Gallons: P T ____ Date ____

Pump Make ____ Model ____ Serial # ____

No. Nitrification Fields: 1 No. Lines 4 Linear Feet 480

Trench Width 36" Max. Trench Bottom Depth 36" Gravel Depth N/A

☑ New System ☐ Repair ☐ Expansion System Type I II (III) IV V VI

System Description: 25% Reduction - Gravity

Repair System Description: 25% Reduction - Gravity

Maintenance Agreement Required ☐ YES ☑ NO

☑ GRAVITY ☐ PRESSURE

☑ Residence No. Bedrooms 4

☐ Business No. Persons ____

☐ Other No. Employees ____

☐ Slab ☑ Crawl Space


☐ Basement w/plumbing ☐ Basement w/o plumbing

Water Supply: ☑ Private ☐ Public ☐ Community


Comments / Conditions - Install a 25% Reduction system on contour with serial distribution.

N/A

INITIAL SITE SKETCH

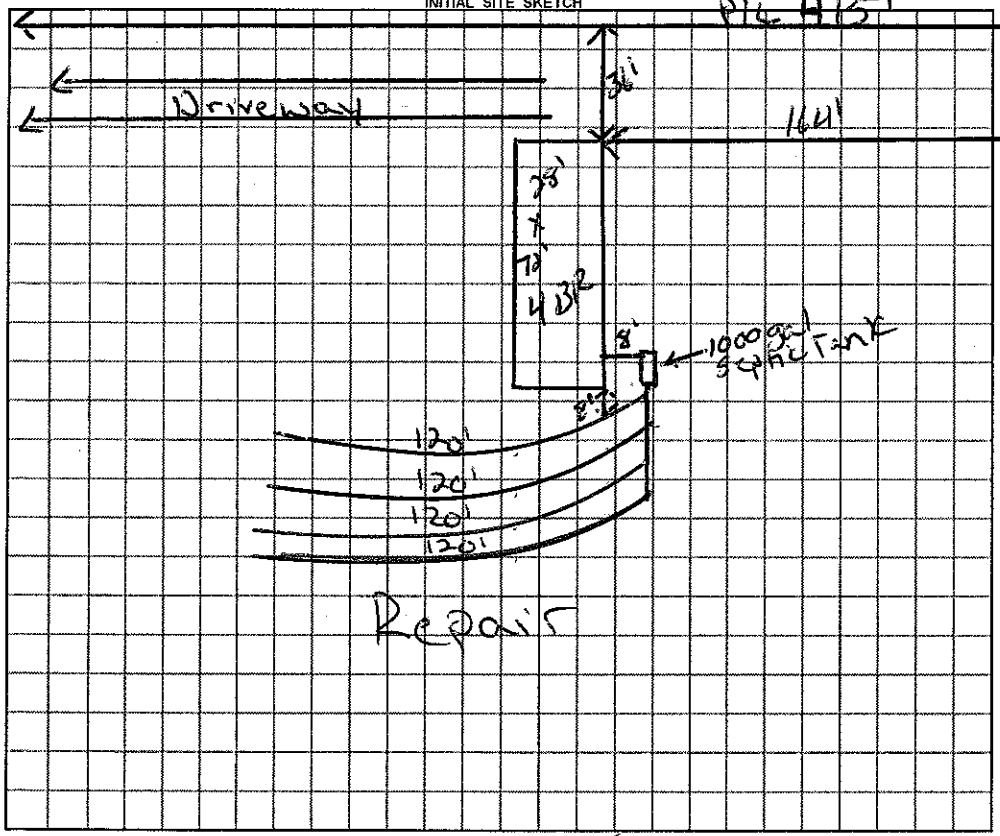

AS BUILT SKETCH

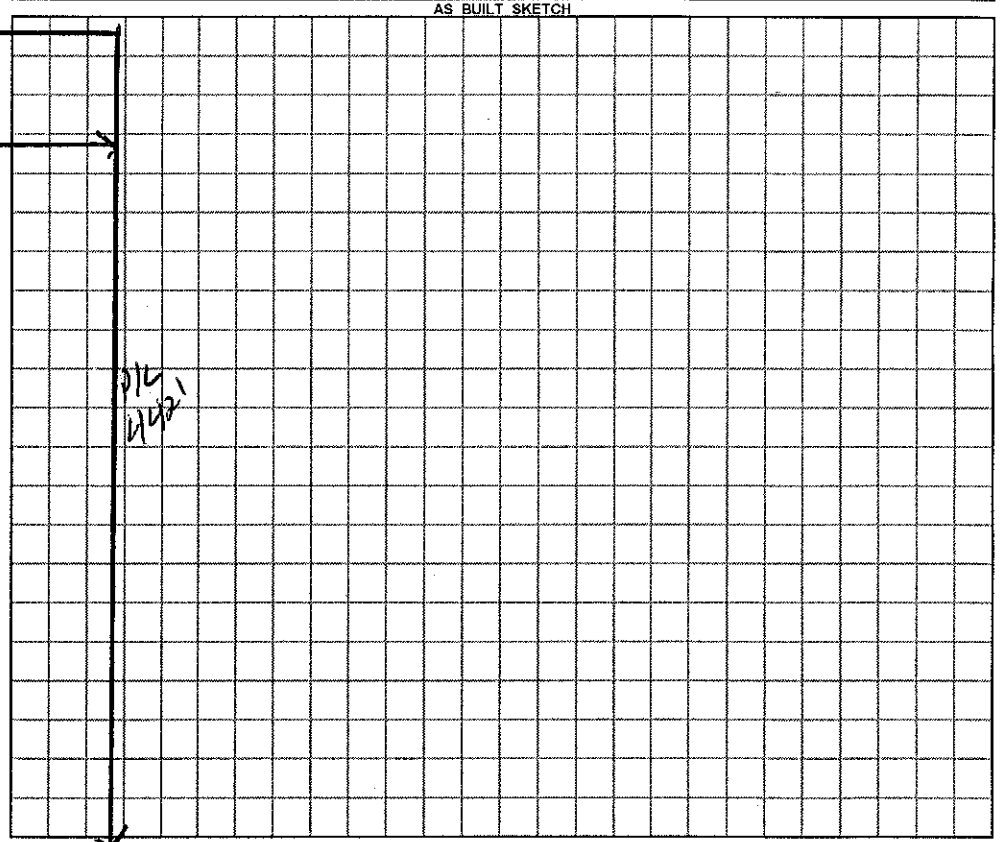

Permit can be suspended or revoked if any false information is supplied toward securing the permit / any unauthorized changes are made to the site / any unauthorized changes are made in the installation of the system.

☐ ***IMPROVEMENT PERMIT*** with plat valid without expiration. ☑ ***IMPROVEMENT PERMIT*** with plat valid without expiration. site plan valid 60 mo. ☑ ***AUTHORIZATION TO CONSTRUCT*** valid for period equal to IMPROVEMENT PERMIT--not to exceed 60 mo.

Owner / Applicant Signature: Sarah Blackwell Date 6-22-12 Installed by: Groundbreakers

IMPROVEMENT PERMIT by: Justin Henderson REHS Date 6-18-12 OPERATION PERMIT by: ____ REHS Date 8-15-12

AUTHORIZATION TO CONSTRUCT by: Justin Henderson REHS Date 6-18-12 Existing System Inspected by: ____ REHS Date ____

YOU SHOULD CONTACT A LOCATOR SERVICE PRIOR TO ANY EXCAVATION

White Copy – Environmental Health YELLOW COPY (Final) Owner / Applicant PINK COPY (Initial) Owner / Applicant