IREDELL COUNTY HEALTH DEPARTMENT

Statesville Office (704) 878-5305 Mooresville Office (704) 660-3625 PERMIT # 176168

IMPROVEMENT PERMIT / AUTHORIZATION TO CONSTRUCT / OPERATION PERMIT / EXISTING SYSTEM

PIN # 4727887591

APPLICANT: ZMH Homes Inc APPLICANT ADDRESS: P.O. Box 9790 Maryville, TN 37801

SITE ADDRESS: Yadkin Valley Rd Statesville, NC 28625 PHONE: 865 380 3000 ALT. PHONE:

SITE DIRECTIONS: Hwy 115, (R) on Yadkin Valley Rd, Property on R, Almost at end, in front of stop sign ahead sign

SUBDIVISION: Deer Creek Meadows SECTION: LOT # 4 LOT AREA: 5ac DESIGN FLOW: 360 L.T.A.R.: .3

Septic Tank 1000 (gal) STB 1012 Date 2-29-12
Pump Tank (gal) PT Date
Pump Make Model Serial #
Nitrification Fields 1 # Lines 3 Linear Ft: 300
Trench Width 36" Max. Trench Bottom Depth 36" Gravel Depth n/a


☒ New System ☐ Repair ☐ Expansion System Type: I II (III) IV V VI
System Description: 25% Reduction
Repair System Description: 25% Reduction
Maintenance Agreement Required: ☐ YES ☒ NO
☒ GRAVITY ☐ PRESSURE

☒ Residence No. Bedrooms 3
☐ Business No. Persons
☐ Other No. Employees
☐ Slab ☒ Crawl Space
☐ Basement w/plumbing ☐ Basement w/o plumbing

Water Supply: ☒ Private ☐ Public ☐ Community

Comments / Conditions:

INITIAL SITE SKETCH

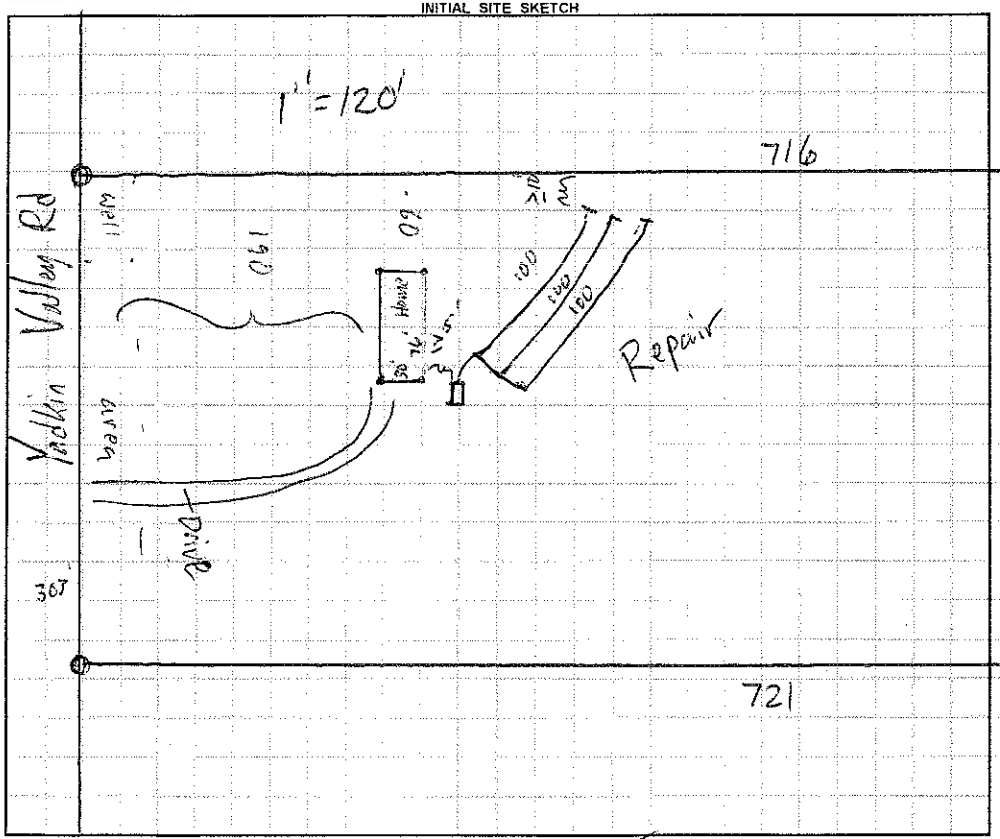

AS BUILT SKETCH

104W (Red Filter

Permit can be suspended or revoked if any false information is supplied toward securing the permit / any unauthorized changes are made to the site / any unauthorized changes are made in the installation of the system. CONTACT A LOCATOR SERVICE PRIOR TO ANY EXCAVATION

☐ IMPROVEMENT PERMIT *with plat* valid without expiration. ☒ IMPROVEMENT PERMIT *with site plan* valid for 60 mos. ☒ AUTHORIZATION TO CONSTRUCT valid for period equal to IMPROVEMENT PERMIT--not to exceed 60 mo.

Owner / Applicant Signature: Date: Installed by: Groundbreakers

IMPROVEMENT PERMIT by: Date: 12-19-12 OPERATION PERMIT by: Date: 1-28-13

AUTHORIZATION TO CONSTRUCT by: Date: 12-18-12 Existing System Inspected by: Date:

Health Dept. Copy - WHITE Applicant (Final Approval) - YELLOW Applicant (Conditional Approval) - PINK