IREDELL COUNTY HEALTH DEPARTMENT

Statesville Office (704) 878-5305 Mooresville Office (704) 660-3625 PERMIT # 214573

IMPROVEMENT PERMIT / AUTHORIZATION TO CONSTRUCT / OPERATION PERMIT / EXISTING SYSTEM

PIN # 4727-88-7880 ✓

APPLICANT: William Kacerek APPLICANT ADDRESS: 25 Spyros Dr S. Amboy NJ

SITE ADDRESS: 462 Yadkin Valley Rd PHONE: 609-661-1326 ALT. PHONE: Deena Abee 704-239-3693

SITE DIRECTIONS: 115 N from Statesville, TR Branchwood, TR Yadkin Valley, Lot on L


SUBDIVISION: Deer Creek Meadows SECTION: LOT # 5 LOT AREA: 5.059 ac DESIGN FLOW: 480gpd L.T.A.R.: 0.25

Septic Tank	1000 (gal)	STB	760	Date	4-12-16	☑ New System ☐ Repair ☐ Expansion System Type: I II III IV V VI	☑ Residence	No. Bedrooms	4
Pump Tank	NA (gal)	PT	NA	Date	NA	System Description: Gravity 25% Reduction	☐ Business	No. Persons	8
Pump Make	NA Model	Pow/Flo		Serial #	PL-66	Repair System Description: Gravity 25% Reduction	☐ Other	No. Employees	
# Nitrification Fields	1 # Lines	3		Linear Ft:	480'	Maintenance Agreement Required: ☐ YES ☑ NO	☐ Slab	☑ Crawl Space	
Trench Width	36" Max. Trench Bottom Depth	36"		Gravel Depth	N/A	☑ GRAVITY ☐ PRESSURE	☐ Basement w/plumbing	☐ Basement w/o plumbing	

Water Supply: ☑ Private ☐ Public ☐ Community

Comments / Conditions: Keep lines on contour in area shown.

INITIAL SITE SKETCH

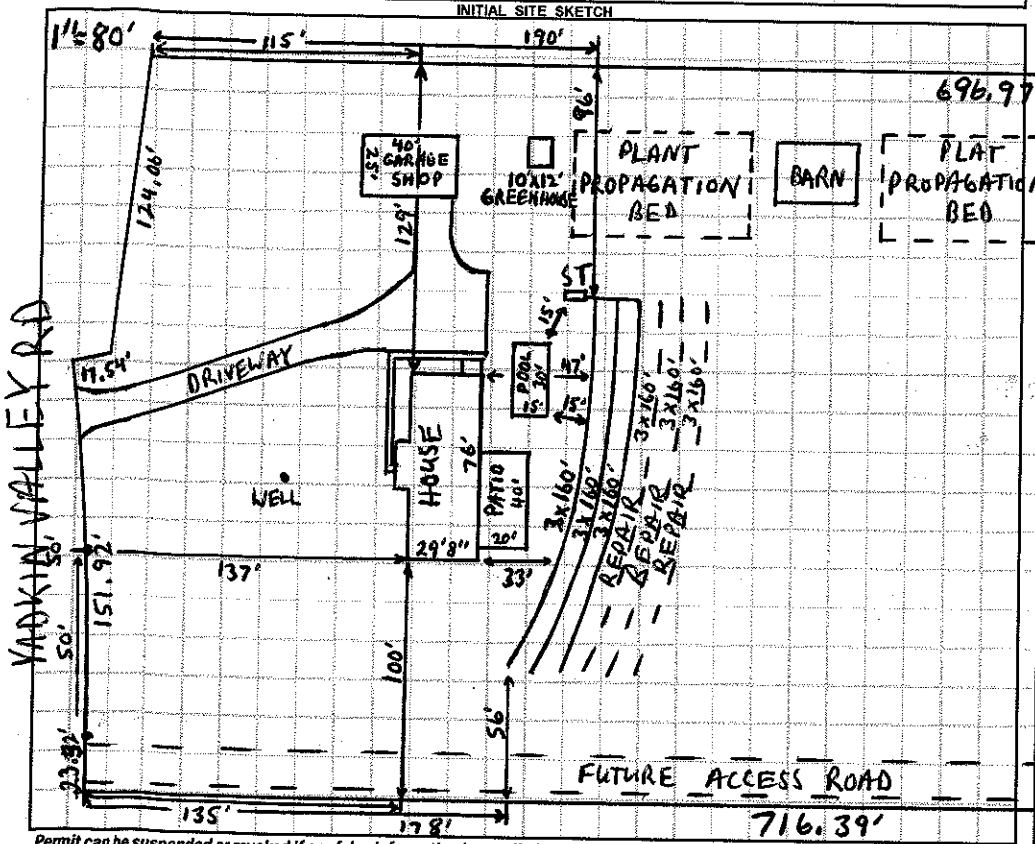

AS BUILT SKETCH

Installed Arc 36 as drawn

Permit can be suspended or revoked if any false information is supplied toward securing the permit / any unauthorized changes are made to the site / any unauthorized changes are made in the installation of the system. **CONTACT A LOCATOR SERVICE PRIOR TO ANY EXCAVATION**

☐ **IMPROVEMENT PERMIT** *with plat valid without expiration.* ☑ **IMPROVEMENT PERMIT** *with site plan valid for 60 mos.* ☑ **AUTHORIZATION TO CONSTRUCT** *valid for period equal to IMPROVEMENT PERMIT--not to exceed 60 mo.*

Owner / Applicant Signature: [signature] Date: 1/13/16 Installed by: Abee's Grading & Clearing

IMPROVEMENT PERMIT by: [signature] Date: 1-12-16 OPERATION PERMIT by: [signature] Date: 07/05/16

AUTHORIZATION TO CONSTRUCT by: Justin Henderson Date: 5-25-16 Existing System Inspected by: Date:

Health Dept. Copy - WHITE Applicant (Final Approval) - YELLOW Applicant (Conditional Approval) - PINK