11530

IREDELL COUNTY HEALTH DEPARTMENT - *ENVIRONMENTAL HEALTH* ☐ STATESVILLE OFFICE 704-878-5305 ☐ MOORESVILLE OFFICE 704-664-5281

IMPROVEMENT PERMIT / AUTHORIZATION TO CONSTRUCT / OPERATION PERMIT / EXISTING SYSTEM INSPECTION

PERMIT # 171381 PIN # 4727-88-9068 DATE MARCH 21, 2012

OWNER JIMMY R. HALL APPLICANT: SAME PHONE: Home/Cell # 910-282-7559 Business #

SITE ADDRESS YADKIN VALLEY ROAD OWNER / APPLICANT ADDRESS 217 RENSHAW FORD ROAD, WOODLEAF NC 27054

SITE DIRECTIONS NS 115 N TR YADKIN VALLEY ROAD, LOT ON RIGHT JUST PAST BOX #386

SUBDIVISION DEER CREEK MEADOWS BLOCK / SECTION LOT # 3 LOT AREA 3.51 ACRES DESIGN FLOW 360 L.T.A.R. 0.30 GPD/FT2

Septic Tank 1000 Gallons: STB 1012 Date 11-15-11
Pump Tank Gallons: P T Date
Pump Make Model Serial #
No. Nitrification Fields: 1 No. Lines 4 Linear Feet 400
Trench Width 36" Max. Trench Bottom Depth 36" Gravel Depth 12"


☑ New System ☐ Repair ☐ Expansion System Type I II III IV V VI
System Description: CONVENTIONAL GRAVITY
Repair System Description: CONVENTIONAL GRAVITY
Maintenance Agreement Required ☐ YES ☑ NO
☑ GRAVITY ☐ PRESSURE

☑ Residence No. Bedrooms 3
☐ Business No. Persons
☐ Other No. Employees
☐ Slab ☑ Crawl Space
☐ Basement w/plumbing ☐ Basement w/o plumbing


Water Supply: ☑ Private WELL ☐ Public ☐ Community

Comments / Conditions: INSTALL SYSTEM ON CONTOUR AT LOCATION SHOWN. AN "ACCEPTED SYSTEM" MAY ALSO BE USED. KEEP SYSTEM MINIMUM 100 FEET FROM WELL. USE SERIAL DISTRIBUTION

INITIAL SITE SKETCH

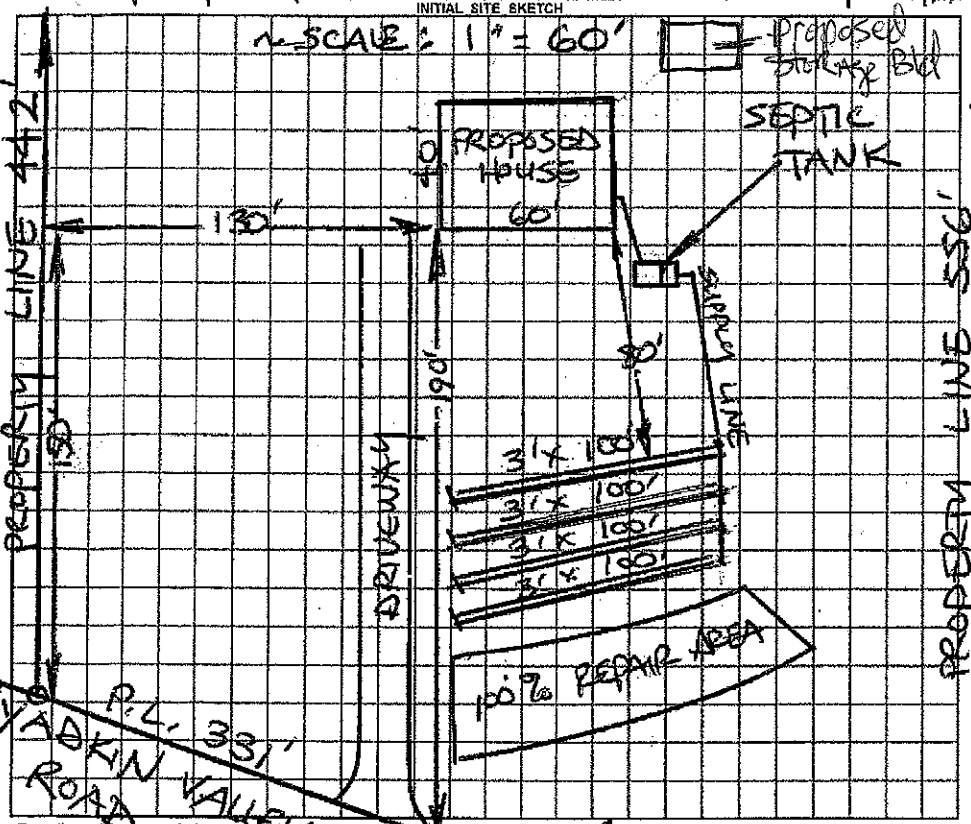

AS BUILT SKETCH

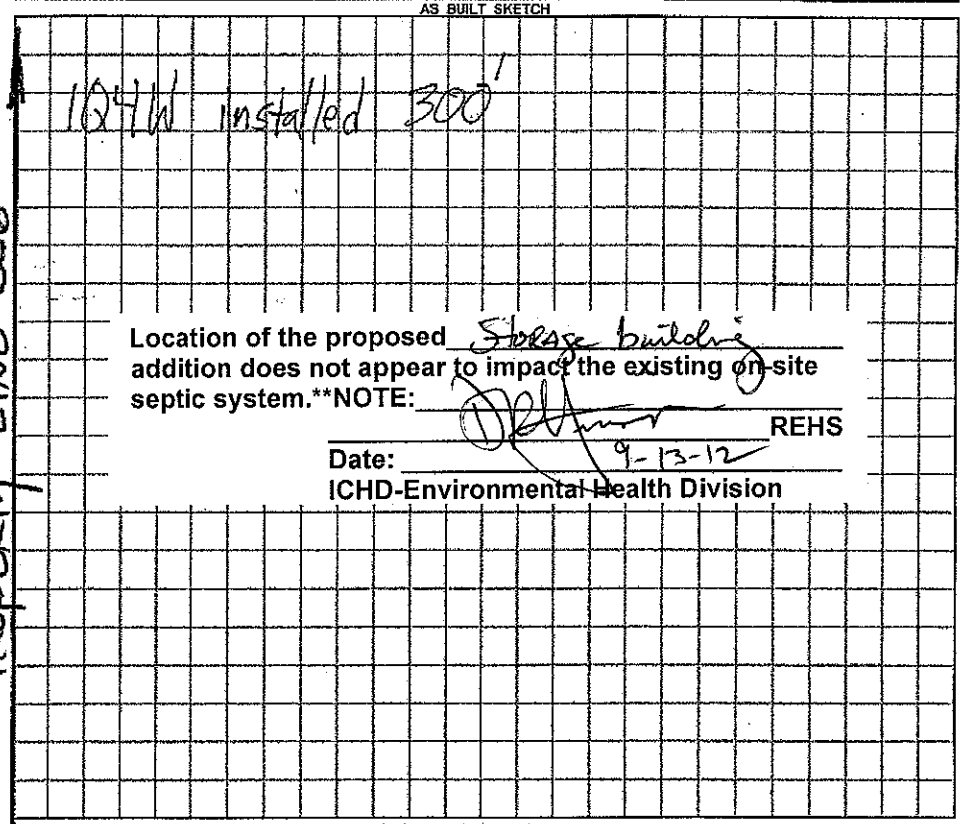

Location of the proposed Storage building addition does not appear to impact the existing on-site septic system.**NOTE:

REHS

Date: 9-13-12

ICHD-Environmental Health Division

Permit can be suspended or revoked if any false information is supplied toward securing the permit / any unauthorized changes are made to the site / any unauthorized changes are made in the installation of the system.

☐ *IMPROVEMENT PERMIT* with plat valid without expiration. ☐ *IMPROVEMENT PERMIT* with plat valid without expiration. Site plan valid 5 years. ☐ *AUTHORIZATION TO CONSTRUCT* valid for period equal to IMPROVEMENT PERMIT--not to exceed 60 mo.

Owner / Applicant Signature: J R Hall Date 3-23-12 Installed by: Steve Jordan

IMPROVEMENT PERMIT by: STEVE HEDRICK REHS Date 3-21-12 OPERATION PERMIT by: REHS Date 8-8-12

AUTHORIZATION TO CONSTRUCT by: REHS Date 9-13-12 Existing System Inspected by: REHS Date

YOU SHOULD CONTACT A LOCATOR SERVICE PRIOR TO ANY EXCAVATION

White Copy – Environmental Health YELLOW COPY (Final) Owner / Applicant PINK COPY (Initial) Owner / Applicant