IREDELL COUNTY HEALTH DEPARTMENT

STATESVILLE 704-878-5305 MOORESVILLE 704-664-5281

IMPROVEMENT PERMIT / AUTHORIZATION TO CONSTRUCT / OPERATION PERMIT / EXISTING SYSTEM INSPECTION

PERMIT# 077054 PIN# 4738 01 4179 (PART) DATE 11-3-98

OWNER OR CONTRACTOR CRAVEN & OTHERS PHONE: Business Home 872-6695

ADDRESS 374 LONG ISLAND ROAD, STATESVILLE NC 28677

LOCATION NC 115 N, TR BRANCHWOOD TL, RIVERFIELD DRIVE, 1ST LOT ON LEFT

SUBDIVISION RIDGECREST BLOCK / SECTION LOT 82' LOT AREA 0.771 ACRE SITE CLASS PS DESIGN FLOW 360 L.T.A.R. 0.25 GPD/FT²

Septic Tank: 1000 Gallons; STB 1012 Date 9-19-98
Pump Tank: Gallons; PT Date
Pump Make: Model Serial No. 240
Nitrification Field: No Fields 1 Square Feet 1440 Linear Feet ~~480~~
No Lines SIX Trench Width 24" Max Trench Bottom Depth 36" ~~Gravel~~ Depth SAND 6"

☑ New System ☐ Repair System Type: I, II, III, IV, V, VI
System Description: PPBPS GRAVITY
Repair System Description: CONVENTIONAL PUMP
Maintenance Agreement Required: ☐ Yes ☑ No

☐ House/Mod. Home ☑ Mobile Home ☐ Business ☐ Other
No. Bedrooms 3 No. Bathrooms 2 No. Employees


☐ Slab ☑ Crawl Space ☐ Basement w/plumbing ☐ Basement wo/plumbing

Water Supply: ☐ Individual ☑ Public ☐ Community

Comments:/Conditions: INSTALL FIFTY-FOUR PPBPS PANELS IN SIX EQUAL LENGTH LINES ON CONTOUR AS SHOWN

Comments:/Conditions: SYSTEM INSTALLED ACCORDING TO INITIAL SITE SKETCH AND GRADE RESULTING IN DEEPER INSTALLATION THAN RECOMMENDED (AS PERMITTED)

INITIAL SITE SKETCH SCALE: 1" = 40'

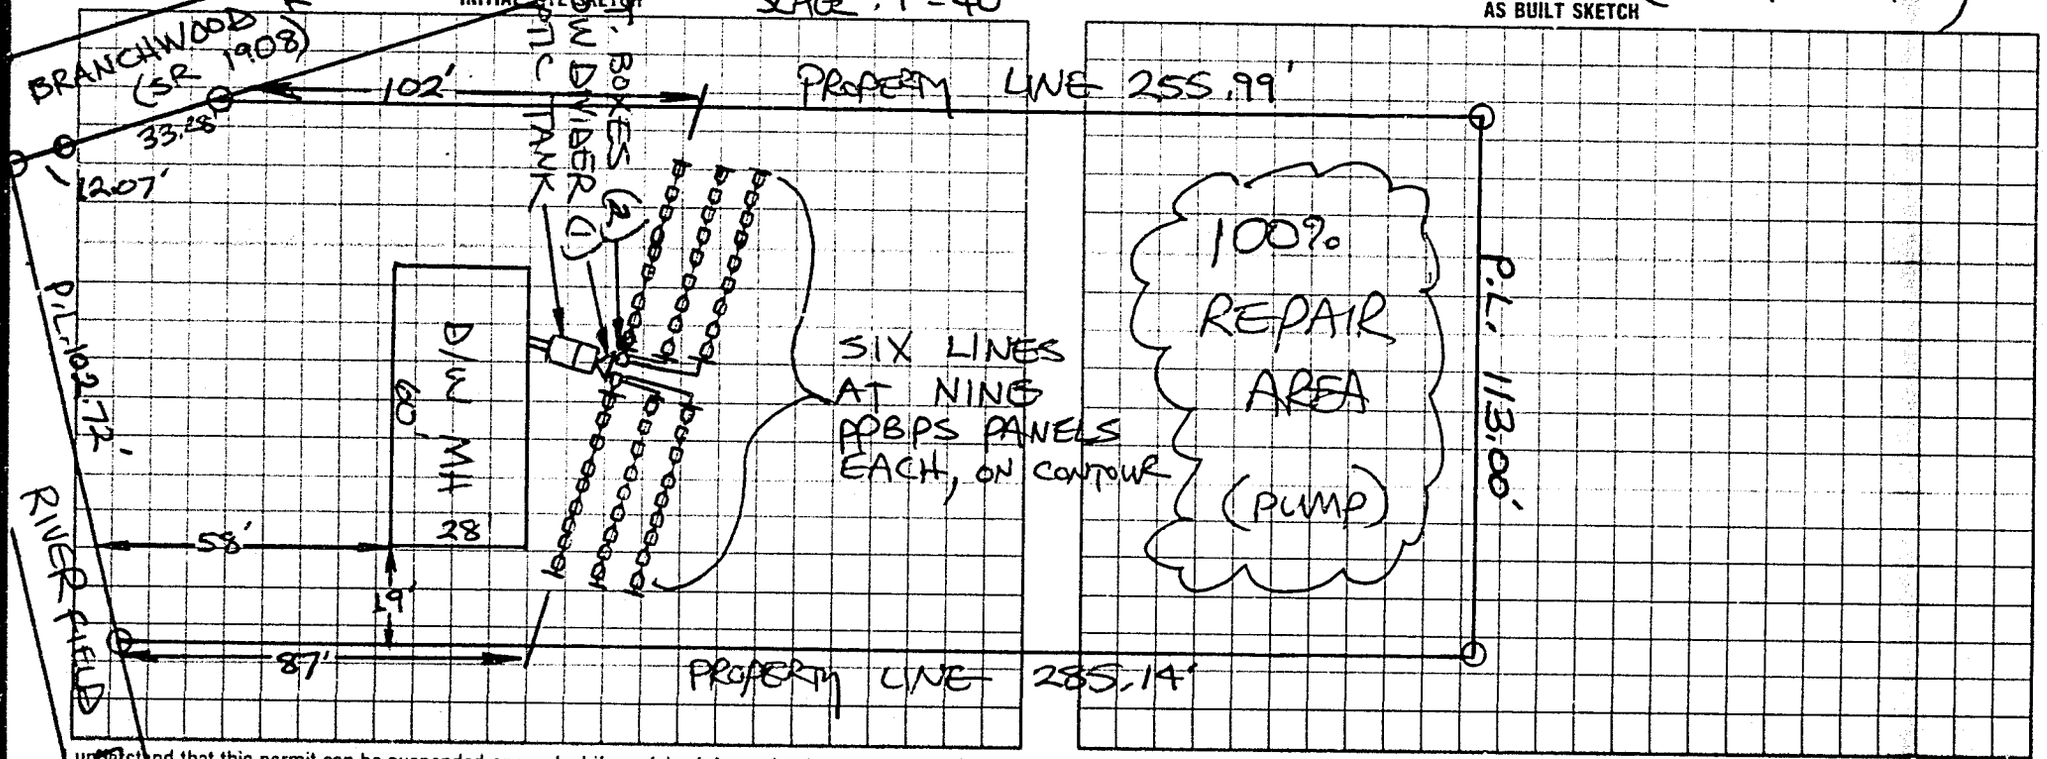

AS BUILT SKETCH

understand that this permit can be suspended or revoked if any false information is supplied toward securing the permit/any unauthorized changes are made to the site/any unauthorized changes are made in the installation of the system. Improvement Permit with plat valid without expiration. Improvement Permit with site plan valid for sixty months. Authorization to Construct is valid for a period equal to that of Improvement Permit – not to exceed sixty months.

Signed: date 11-3-98

Improvement Permit by: STEVE HENDRICK date 11-3-98

Authorization to Construct by: STEVE HENDRICK date 11-3-98

Installed by: A-1 BACKHOE

Operation Permit by: STEVE HENDRICK date 11-30-98

Existing System Inspection by: date

HEALTH DEPT. COPY: WHITE INSPECTION COPY (FINAL): GREEN OWNER COPY (FINAL): YELLOW INSPECTION COPY (INITIAL): PINK OWNER COPY (INITIAL): GOLD

11808