IREDELL COUNTY HEALTH DEPARTMENT

STATESVILLE 704-878-5305 MOORESVILLE 704-664-5281

IMPROVEMENT PERMIT / AUTHORIZATION TO CONSTRUCT / OPERATION PERMIT / EXISTING SYSTEM INSPECTION

PERMIT# 077053 PIN# 4738 01 4179 (PART) DATE 11-2-98

OWNER OR CONTRACTOR CRAVEN & OTHERS PHONE: Business Home 872-6695

ADDRESS 374 LONG ISLAND ROAD, STATESVILLE, NC 28677

LOCATION NC 115 N, TR BRANCHWOOD, TL RIVERFIELD, DRIVE, 2ND LOT ON LEFT

SUBDIVISION RIDGECREST BLOCK / SECTION II LOT 83 LOT AREA 0.696 ACRE SITE CLASS PS DESIGN FLOW 360 L.T.A.R. 0.30 GPD/FT²

Septic Tank: 1000 Gallons: STB 1012 Date 1-5-99
Pump Tank: ____ Gallons: PT ____ Date ____
Pump Make: ____ Model ____ Serial No. ____
Nitrification Field: No. Fields 1 Square Feet 1,200 Linear Feet 300
No. Lines FOUR Trench Width 36" Max. Trench Bottom Depth 36

✓ New System ____ Repair ____ System Type I II (III) IV V
System Description: 25% REDUCTION GRAVITY
Repair System Description: CONVENTIONAL PUMP
Maintenance Agreement Required: ____ Yes ✓ No
Gravel Depth SAND 6" Slab ✓ Crawl Space ____ Basement w/plumbing ____ Basement w/o plumbing


✓ House/Mod. Home ✓ Mobile Home ____ Business ____ Other
No. Bedrooms 3 No. Bathrooms 2 No. Employees ____

Water Supply: ☐ Individual ✓ Public ☐ Community

Comments/Conditions: ① INSTALL 25% REDUCTION SYSTEM USING FIFTY 6' CHAMBERS OR THIRTY H.D.S. SECTIONS ② KEEP TRENCHES FREE OF BACKFILL FOR INSPECTION

Comments/Conditions: SEPTIC TANK W/ RISERS INSTALLED W/ "POLYLOK" FILTER

INITIAL SITE SKETCH SCALE: 1" = 40'

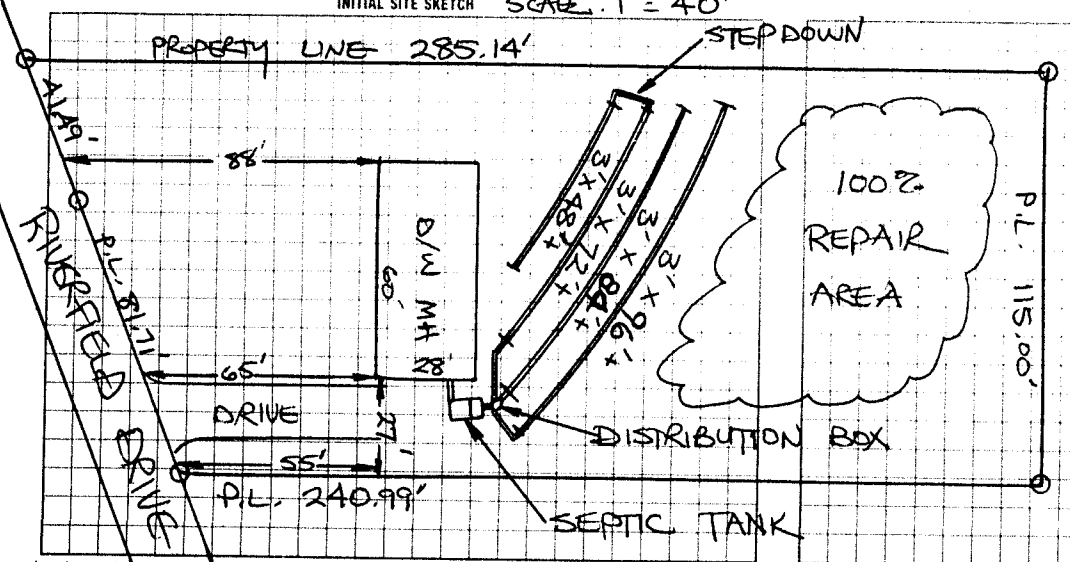

AS BUILT SKETCH

SYSTEM INSTALLED ACCORDING TO INITAL SITE SKETCH

I understand that this permit can be suspended or revoked if any false information is supplied toward securing the permit/any unauthorized changes are made to the site/any unauthorized changes are made in the installation of the system. Improvement Permit with plat valid without expiration. Improvement Permit with site plan valid for sixty months. Authorization to Construct is valid for a period equal to that of Improvement Permit – not to exceed sixty months.

Signed: ____ date 11-3-98 Installed by: A-1 BACKHOE

Improvement Permit by: STEVE HEDRICK date 11-2-98 Operation Permit by: STEVE HEDRICK date 3-12-99

Authorization to Construct by: STEVE HEDRICK date 11-2-98 Existing System Inspection by: ____ date ____

HEALTH DEPT. COPY: WHITE INSPECTION COPY (FINAL): GREEN OWNER COPY (FINAL): YELLOW INSPECTION COPY (INITIAL): PINK OWNER COPY (INITIAL): GOLD