IREDELL COUNTY HEALTH DEPARTMENT

STATESVILLE 704-878-5305 MOORESVILLE 704-664-5281

IMPROVEMENT PERMIT / AUTHORIZATION TO CONSTRUCT / OPERATION PERMIT / EXISTING SYSTEM INSPECTION

PERMIT# 077052 PIN# 4738 01 4179 (PART) DATE 11-2-98

OWNER OR CONTRACTOR CRAVEN & OTHERS PHONE: Business Home 872-6645

ADDRESS 374 LONG ISLAND ROAD, STATESVILLE, NC 28677

LOCATION NC 115 N, TR BRANCHWOOD, TL RIVERFIELD, 3RD LOT ON LEFT

SUBDIVISION RIDGECREST BLOCK / SECTION II LOT 84 LOT AREA 0.607 ACRE SITE CLASS PS DESIGN FLOW 360 L.T.A.R. 0.30 GPD/FT²

Septic Tank: 1000 Gallons; STB 1012 Date 6-23-99
Pump Tank: ____ Gallons; PT ____ Date ____
Pump Make: ____ Model ____ Serial No ____
Nitrification Field: No Fields 1 Square Feet 1200 Linear Feet 400
No Lines FIVE Trench Width 36" Max Trench Bottom Depth 36" Gravel Depth 12"

✓ New System Repair System Type: I II III IV V VI
System Description: CONVENTIONAL GRAVITY
Repair System Description: 25% REDUCTION PUMP
Maintenance Agreement Required: Yes ✓ No

✓ House/Mod. Home No. Bedrooms 3
✓ Mobile Home No. Bathrooms 2
Business No. Employees ____
Other ____


Slab ✓ Crawl Space Basement w/plumbing Basement w/o plumbing

Water Supply: ☐ Individual ✓ Public ☐ Community


Comments/Conditions:

Comments/Conditions:

INITIAL SITE SKETCH SCALE: 1" = 40'

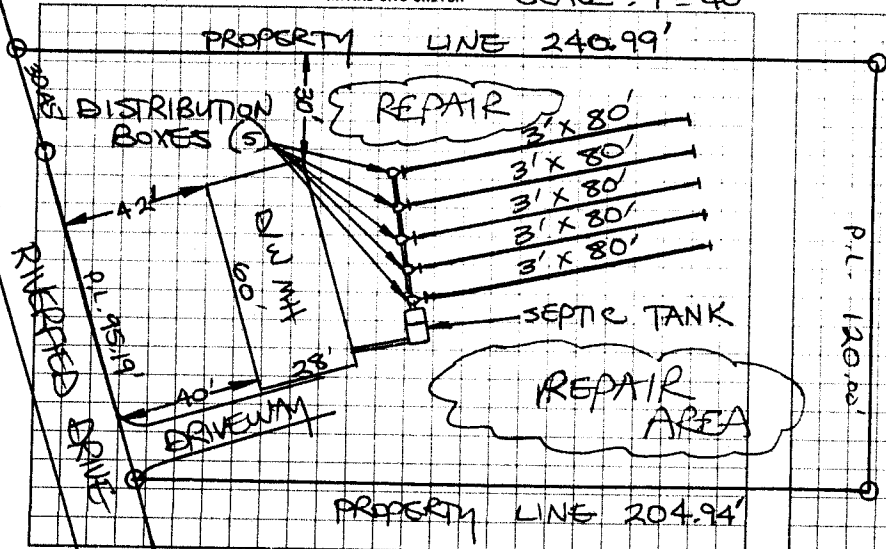

AS BUILT SKETCH

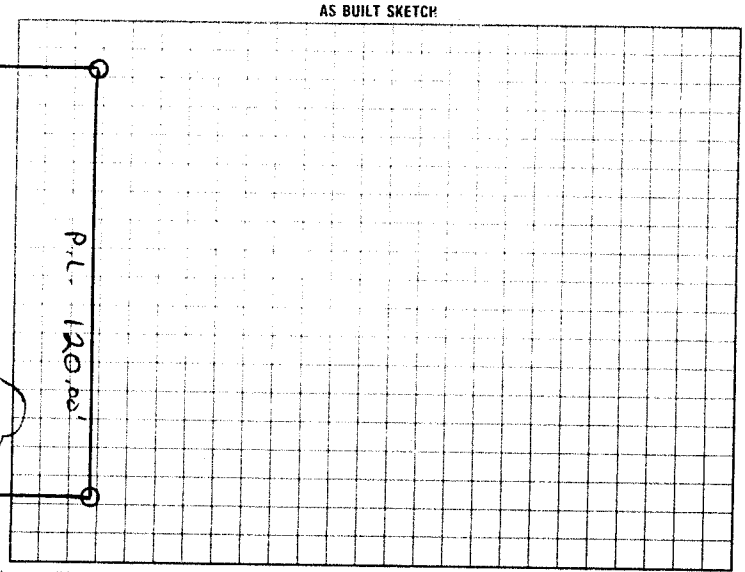

I understand that this permit can be suspended or revoked if any false information is supplied toward securing the permit/any unauthorized changes are made to the site/any unauthorized changes are made in the installation of the system. Improvement Permit with plat valid without expiration. Improvement Permit with site plan valid for sixty months. Authorization to Construct is valid for a period equal to that of Improvement Permit – not to exceed sixty months.

Signed: ____ date 11-3-98

Improvement Permit by: STEVE HEDRICK date 11-2-98

Authorization to Construct by: STEVE HEDRICK date 11-2-98

Installed by: A1 Backhoe

Operation Permit by: [signature] date Aug 30 99

Existing System Inspection by: ____ date ____

HEALTH DEPT. COPY: WHITE INSPECTION COPY (FINAL): GREEN OWNER COPY (FINAL): YELLOW INSPECTION COPY (INITIAL): PINK OWNER COPY (INITIAL): GOLD