IREDELL COUNTY HEALTH DEPARTMENT

STATESVILLE 704-878-5305 MOORESVILLE 704-664-5281

IMPROVEMENT PERMIT / AUTHORIZATION TO CONSTRUCT / OPERATION PERMIT / EXISTING SYSTEM INSPECTION

PERMIT# 077051 PIN# 4738 01 4179 (PART) DATE 10-14-98

OWNER OR CONTRACTOR CRAVEN & OTHERS PHONE: Business Home 881-7273

ADDRESS 374 LONG ISLAND ROAD, STATESVILLE, NC 28677

LOCATION NC 115 N, TR BRANCHWOOD ROAD, TL RIVERFIELD DRIVE, 2ND LOT ON RIGHT

SUBDIVISION RIDGECREST BLOCK / SECTION II LOT 58 LOT AREA 0.53 ACRE SITE CLASS. PS 1 DESIGN FLOW 360 L.T.A.R. 0.30 GPD/FT²

Septic Tank: 1000 Gallons; STB 1012 Date 9-20-98
Pump Tank: Gallons; PT Date
Pump Make: Model Serial No.
Nitrification Field: No Fields 1 Square Feet 1200 Linear Feet 400
No Lines THREE Trench Width 36" Max Trench Bottom Depth 36" Gravel Depth 12"

☑ New System ☐ Repair System Type: I, II, III, IV, V, VI
System Description: CONVENTIONAL GRAVITY
Repair System Description: 25% REDUCTION
Maintenance Agreement Required: ☐ Yes ☑ No GRAVITY


☐ House/Mod. Home No. Bedrooms 3
☑ Mobile Home No. Bathrooms 2
☐ Business No. Employees
☐ Other
☐ Slab ☑ Crawl Space ☐ Basement w/plumbing ☐ Basement wo/plumbing

Water Supply: ☐ Individual ☑ Public ☐ Community

Comments:/Conditions:

Comments:/Conditions:

INITIAL SITE SKETCH SCALE: 1" = 40'

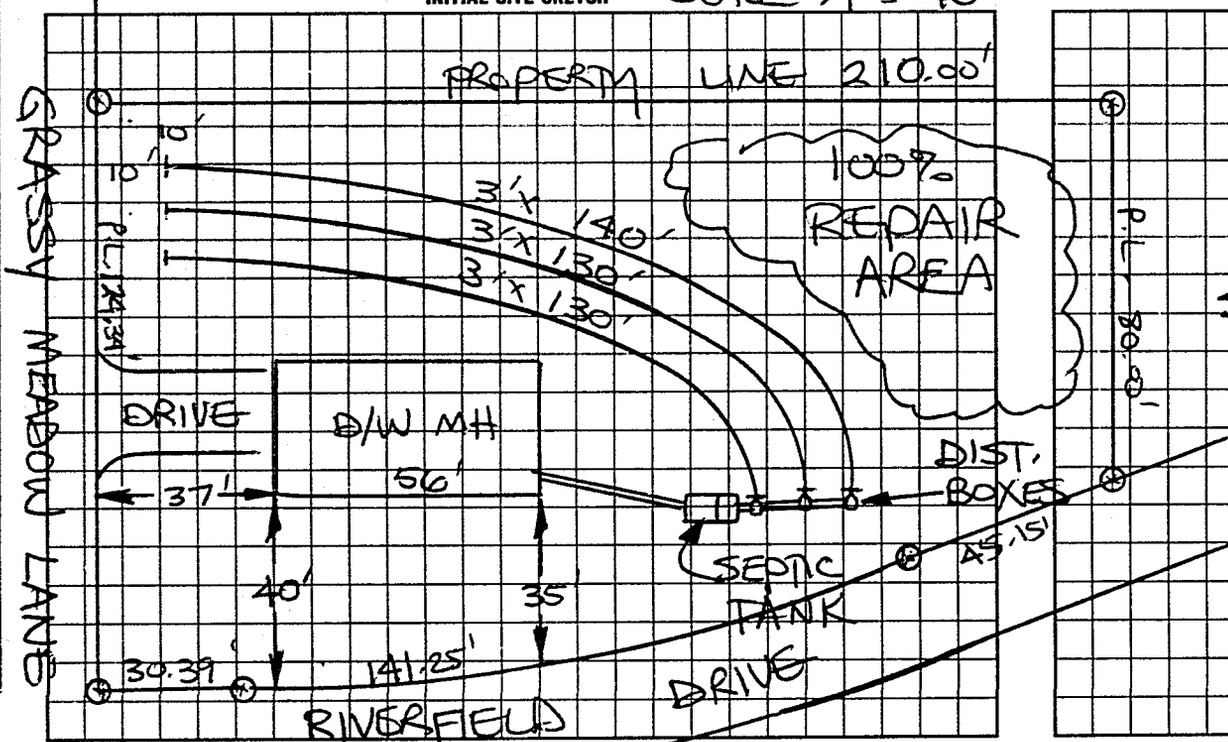

AS BUILT SKETCH

SYSTEM INSTALLED ACCORDING TO INITIAL SITE SKETCH

I understand that this permit can be suspended or revoked if any false information is supplied toward securing the permit/any unauthorized changes are made to the site/any unauthorized changes are made in the installation of the system. Improvement Permit with plat valid without expiration. Improvement Permit with site plan valid for sixty months. Authorization to Construct is valid for a period equal to that of Improvement Permit – not to exceed sixty months.

Signed: date

Improvement Permit by: STEVE HEDRICK date 10-14-98

Authorization to Construct by: STEVE HEDRICK date 10-14-98

Installed by: A-1 BACKHOE

Operation Permit by: STEVE HEDRICK date 11-24-98

Existing System Inspection by: date

HEALTH DEPT. COPY: WHITE INSPECTION COPY (FINAL): GREEN OWNER COPY (FINAL): YELLOW INSPECTION COPY (INITIAL): PINK OWNER COPY (INITIAL): GOLD

108000