IREDELL COUNTY HEALTH DEPARTMENT

STATESVILLE 704-878-5305 MOORESVILLE 704-664-5281

IMPROVEMENT PERMIT / CERTIFICATE OF COMPLETION / OPERATION PERMIT / EXISTING SYSTEM INSPECTION

PROPERTY DESCRIPTION NO. 25979 DATE 2-24-97 TAX MAP NO. 4738 00 6849 Watershed: ☐ Yes ☑ No

OWNER OR CONTRACTOR CRAVEN, KEARNS, MCDOWELL PHONE: Business (910)-672-2269 Home

ADDRESS P.O. Box 2257, ASHEBORO, NC 27204

LOCATION NC 115N, TR BRANCHWOOD RD 1ST LOT ON LEFT PAST YADKIN VALLEY ROAD.

SUBDIVISION RIDGECREST BLOCK / SECTION 1 LOT 6 LOT AREA 0.725 ACRES SITE CLASS. PS DESIGN FLOW 360 L.T.A.R. 0.33 GPD/FT²

Septic Tank: 1000 Gallons; STB 821 Date 9-5-97

Pump Tank: Gallons; PT Date

Pump Make: Model Serial No.

Nitrification Field: No Fields 1 Square Feet 1080 Linear Feet 360

No Lines THREE Trench Width 36" Max Trench Bottom Depth 36" Gravel Depth 12"

☑ New System ☐ Repair System Type: I, II, III, IV, V, VI

System Description: CONVENTIONAL GRAVITY

Repair System Description: CONV. GRAVITY

Maintenance Agreement Required: ☐ Yes ☑ No

☐ House/Mod. Home ☑ Mobile Home ☐ Business ☐ Other

No. Bedrooms 3 No. Bathrooms 2 No. Employees


☐ Slab ☑ Crawl Space ☐ Basement w/plumbing ☐ Basement wo/plumbing

Water Supply: ☐ Individual ☐ Community ☑ Public


Comments: REPAIR AREA LTAR = 0.25 GPD/FT²

Comments:

INITIAL SITE SKETCH

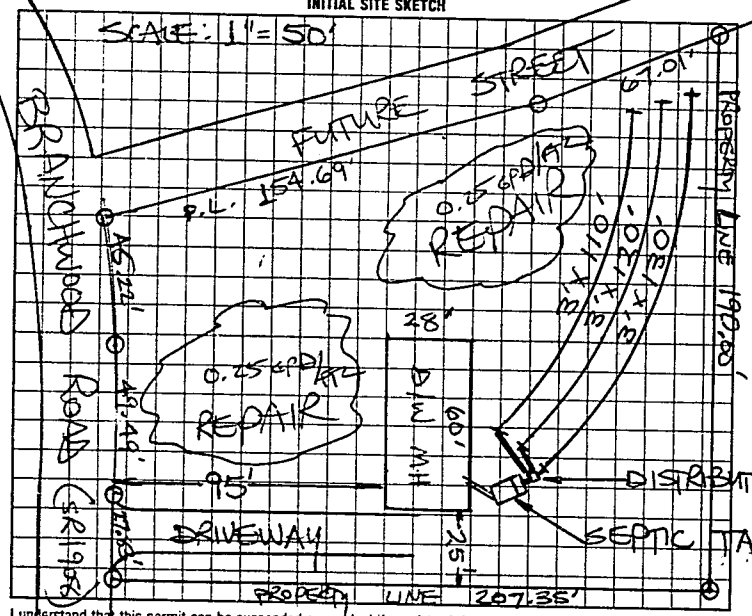

AS BUILT SKETCH

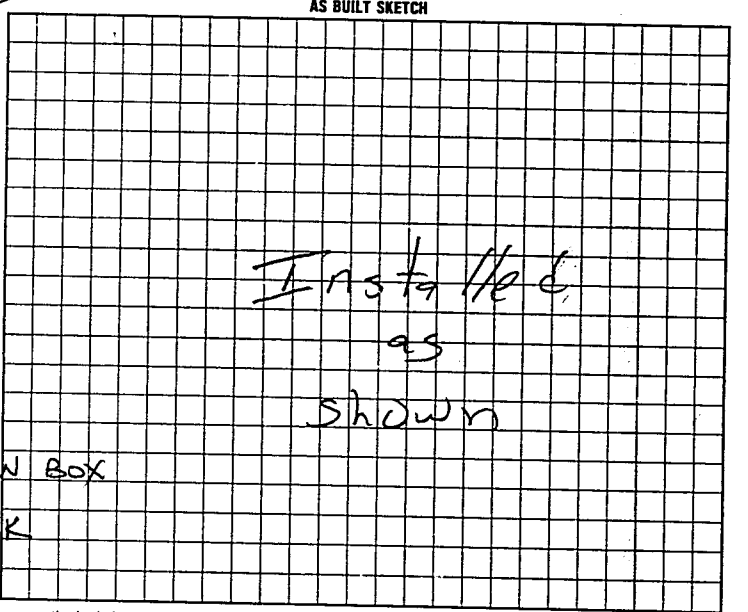

I understand that this permit can be suspended or revoked if any false information is supplied toward securing the permit/any unauthorized changes are made to the site/any unauthorized changes are made in the installation of the system. Improvement Permit is valid for 60 months from date of issuance. AUTHORIZATION TO CONSTRUCT IS VALID FOR 60 MONTHS FROM DATE OF ISSUANCE.

Signed:

Improvement Permit by: STEVE HEDRICK date 2-24-97

AUTH. TO CONST.

Existing System Inspection by: STEVE HEDRICK date 2-24-97

Installed by: G+M Enterprises

Certificate of Completion by: date

Operation Permit by: M. C. O. R. S. date 10-15-97

HEALTH DEPT. COPY: WHITE INSPECTION COPY (FINAL): GREEN OWNER COPY (FINAL): YELLOW INSPECTION COPY (INITIAL): PINK OWNER COPY (INITIAL): GOLD

0 0 0 3 2 0