IREDELL COUNTY HEALTH DEPARTMENT

STATESVILLE 704-878-5305 MOORESVILLE 704-664-5281

IMPROVEMENT PERMIT / AUTHORIZATION TO CONSTRUCT / OPERATION PERMIT / EXISTING SYSTEM INSPECTION

PERMIT# 148151 PIN# 4727960498 2715 DATE 2-29-08

OWNER OR APPLICANT Horne Building

ADDRESS Yadkin Valley Rd. PHONE: Business 704 902 0399 Home 704 878 2224

LOCATION 115 North (R) / Yadkin Valley, Property 2 miles on (R)

SUBDIVISION n/a BLOCK / SECTION ____ LOT ____ LOT AREA 4.56 SITE CLASS. PS DESIGN FLOW 480 L.T.A.R. .03

Septic Tank: 1000 Gallons; STB 1007 Date 7-31-05

Pump Tank: ____ Gallons; PT ____ Date ____

Pump Make: ____ Model ____ Serial No. ____

Nitrification Field: No Fields 1 Square Feet 1600 Linear Feet 400

No Lines 3 Trench Width 36" Max Trench Bottom Depth 36"

☒ New System ☐ Repair ☐ Expansion System Type: I II III IV V VI

System Description: 25% Gravity Reduction

Repair System Description: 25% Gravity Reduction

Maintenance Agreement Required: ☐ Yes ☒ No

Gravel Depth ____ ☒ Gravity ☐ Pressure

☒ House/Mod. Home ☐ Mobile Home ☐ Business ☐ Other

No. Bedrooms 4 No. Persons ____ No. Employees ____

Water Supply: ☒ Individual ☐ Public ☐ Community


☐ Slab ☐ Crawl Space ☐ Basement w/plumbing ☒ Basement wo/plumbing

Comments:/Conditions:

Comments:/Conditions:

Brown Fill

INITIAL SITE SKETCH

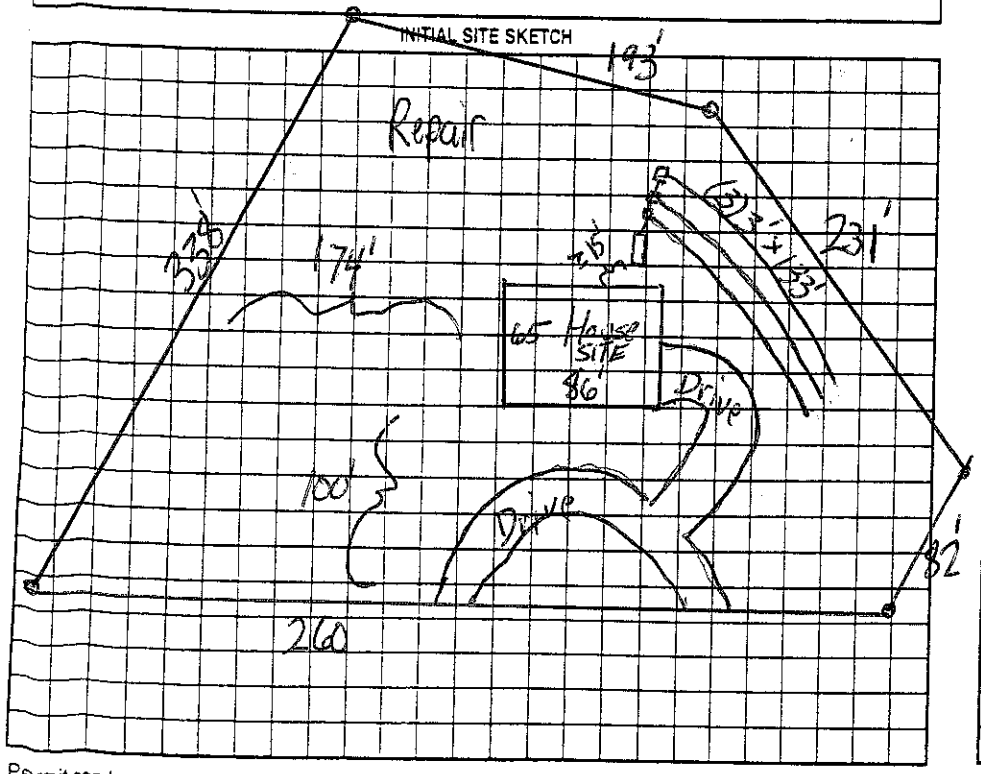

AS BUILT SKETCH

Permit can be suspended or revoked if any false information is supplied toward securing the permit/any unauthorized changes are made to the site/any unauthorized changes are made in the installation of the system. Improvement Permit with plat valid without expiration ☐ Improvement Permit with site plan valid for sixty months ☒ Authorization to Construct is valid for a period equal to that of Improvement Permit – not to exceed sixty months.

Signed: Carolyn B Johnson date 3-6-08

Improvement Permit by: James Horne date 3-4-8

Authorization to Construct by: James Horne date 3-4-8

Installed by: Cothren & Son

Operation Permit by: James Horne date 9-3-8

Existing System Inspection by: ____ date ____

HEALTH DEPT. COPY: WHITE OWNER COPY (FINAL): YELLOW OWNER COPY (INITIAL): PINK