ICHD - ENVIRONMENTAL HEALTH DIVISION

Statesville Office (704) 878-5305 | Mooresville Office (704) 660-3625 | PERMIT # 3010781

SEPTIC: IMPROVEMENT PERMIT / AUTHORIZATION TO CONSTRUCT / OPERATION PERMIT / EXISTING SYSTEM

PIN # 4727990901

APPLICANT/OWNER: Dixieland Inc | APPLICANT ADDRESS: 133 Redemption Rd, Statesville

SITE ADDRESS: 233 Grassy Meadow Ln, Statesville 28625 | PHONE: 704-202-4971 | ALT. PHONE —

SITE DIRECTIONS: I-77 N → R on Branchwood → L Riverfield → R Grassy Meadow → on R | SAP CONTROLLED: ☐ YES ☒ NO

SUBDIVISION: Ridgecrest | SECTION: 3 | LOT # 60 | LOT AREA: .579 ac | DESIGN FLOW: 360 gpd | L.T.A.R.: .3

Septic Tank	1000 (gal)	STB 8354	Date 7-20-20	☒ New System	☐ Repair	☐ Expansion	System Type: I II (III) IV V VI	☒ Residence	No. Bedrooms 3
Pump Tank	1000 (gal)	PT 1109	Date 3-27-20	System Description:			25% reduction- PM	☐ Business	No. Persons 6
Pump Make Gravity	Model 1/3 hp LP	Serial # 1160720		Repair System Description:			UP PD BPS	☐ Other	No. Employees
# Nitrification Fields 1	# Lines	Linear Ft 300'		Maintenance Agreement Required:		☐ YES	☒ NO	☐ Slab	☒ Crawl Space
Trench Width 36"	Trench Bottom Depth (Low side)	36" max	Gravel Depth —			☐ GRAVITY	☒ PRESSURE	☐ Basement w/plumbing	


Water Supply: ☐ Private ☒ Public ☐ Community

☐ Basement w/o plumbing

Comments / Conditions: Install on contour + utilize pressure manifold for distribution. System must remain 25' upslope from house.


- Tap sizes - L1-1/2 sch80 L4-1/2" sch40 L2-1/2" sch40 L3-1/2" sch40
- 136.5 gal dose vol
- 6.48" drawdown

INITIAL SITE SKETCH

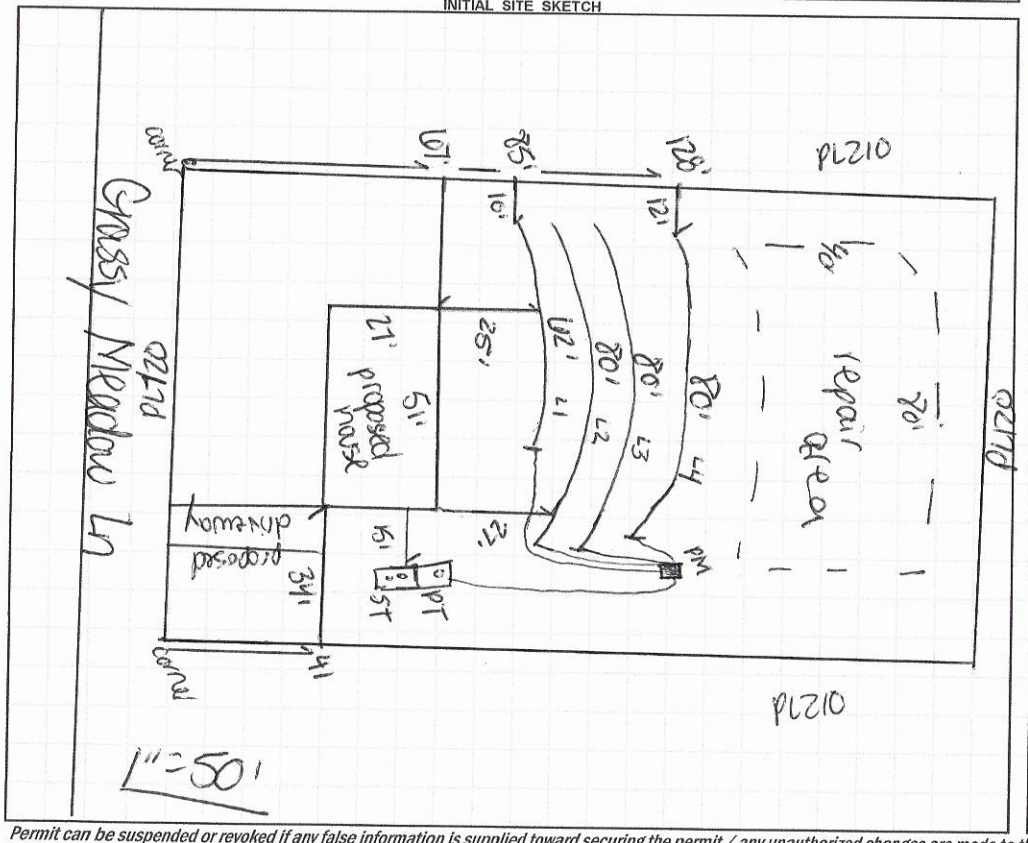

AS BUILT SKETCH

FOR SEPTIC INSPECTION CALL: 704-664-3703 between 8am-9am the day the inspection is needed. Be sure to speak with an inspector to confirm your time.

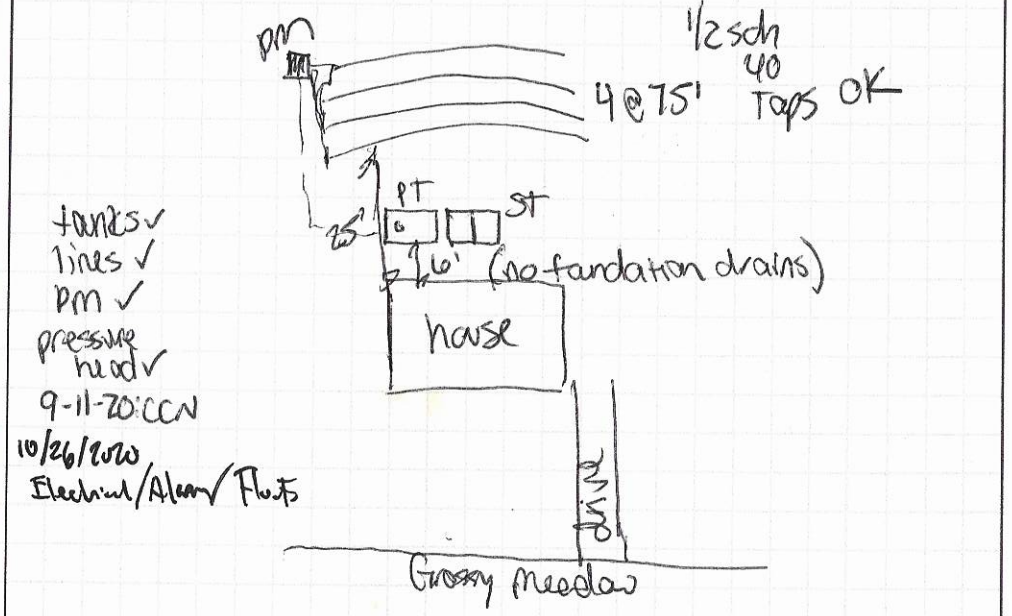

Permit can be suspended or revoked if any false information is supplied toward securing the permit / any unauthorized changes are made to the site / any unauthorized changes are made in the installation of the system. **CONTACT A LOCATOR SERVICE PRIOR TO ANY EXCAVATION**

☐ **IMPROVEMENT PERMIT** *with plat valid without expiration.* ☒ **IMPROVEMENT PERMIT** *with site plan valid for 60 mos.* ☒ **AUTHORIZATION TO CONSTRUCT** *valid for period equal to IMPROVEMENT PERMIT--not to exceed 60 mo.*

Owner / Applicant Signature: Regina C Ouvdle | Date: 6/1/20 | Installed by: Al Bochop

IMPROVEMENT PERMIT by: Carla C. Nicks | Date: 5-27-20 | OPERATION PERMIT by: Bigmann A. Bton | Date: 10/26/2020

AUTHORIZATION TO CONSTRUCT by: Carla C. Nicks | Date: 6-1-20 | Existing System Inspected by: | Date:

FOR SEPTIC FINAL INSPECTION: CALL 704-664-3703 between 8am-9am the day the inspection is needed.

DEPARTMENT OF HEALTH AND HUMAN SERVICES
DIVISION OF PUBLIC HEALTH, ENVIRONMENTAL HEALTH SECTION
ON-SITE WATER PROTECTION BRANCH

Sheet 1 of 1
PROPERTY ID #: 7727910901
COUNTY: Iredell

SOIL/SITE EVALUATION
for ON-SITE WASTEWATER SYSTEM
(Complete all fields in full)

OWNER: Dixieland Inc
ADDRESS: 135 Redemption Dr
APPLICATION DATE: 4-28-20
DATE EVALUATED: 5-26-20
PROPOSED FACILITY: 3BR
PROPOSED DESIGN FLOW (.1949): 360 gpd
PROPERTY SIZE: .57 ac
LOCATION OF SITE: 233 Grassy Meadow
PROPERTY RECORDED: y
WATER SUPPLY: ☐ Private ☑ Public ☐ Well ☐ Spring ☐ Other
EVALUATION METHOD: ☐ Auger Boring ☑ Pit ☐ Cut
TYPE OF WASTEWATER: ☑ Sewage ☐ Industrial Process ☐ Mixed

PROFILE #	.1940 LANDSCAPE POSITION/ SLOPE %	HORIZON DEPTH (IN.)	SOIL MORPHOLOGY (.1941) .1941 STRUCTURE/ TEXTURE	SOIL MORPHOLOGY (.1941) .1941 CONSISTENCE/ MINERALOGY	OTHER PROFILE FACTORS .1942 SOIL WETNESS/ COLOR	.1943 SOIL DEPTH	.1956 SAPRO CLASS	.1944 RESTR HORIZ	PROFILE CLASS & LTAR
1	L 20%	0-8	GR SCL	Fr SS SP SExP	few sap inc in CL	55"	–	–	PS .3
		8-46	SBK C	" "					
		40-55	SBK CL	" "					
2	L 20%	0-9	GR SCL	Fr SS SP SExP	–	49"	–	–	PS .3
		9-37	SBK C	" "					
		37-49	SBK CL	" "					
3	L 20%	0-9	GR SCL	Fr SS SP SExP	many sap inc in CL	54"	–	–	PS .3
		9-37	SBK C	" "					
		37-54	SBK CL	" "					
4	L 20%	0-6	GR SCL	Fr SS SP SExP	–	48"	–	–	PS .3
		6-37	SBK C	" "					
		37-48	SBK CL	" "					

DESCRIPTION	INITIAL SYSTEM	REPAIR SYSTEM
Available Space (.1945)	300'	200'
System Type(s)	2590-PM	LPPPBPS
Site LTAR	.3	.3

OTHER FACTORS (.1946): NA
SITE CLASSIFICATION (.1948): PS
EVALUATED BY: C. Nicks
OTHER(S) PRESENT: A. Snow, B. Watkins

COMMENTS:

LEGEND

use the following standard abbreviations

LANDSCAPE POSITION	GROUP	SOIL TEXTURE	CONVENTIONAL .1955 LTAR*	LPP .1957 LTAR*	MINERALOGY/ CONSISTENCE	STRUCTURE
CC (Concave Slope) CV (Convex Slope) D (Drainage Way) DS (Debris Slump) FP (Flood Plain) FS (Foot Slope) H (Head Slope) L (Linear Slope) N (Nose Slope) R (Ridge) S (Shoulder Slope) T (Terrace)	I	S (Sand) LS (Loamy Sand)	1.2 - 0.8	0.6 - 0.4	SEXP (Slightly Expansive) EXP (Expansive)	G (Single Grain) M (Massive) CR (Crumb) GR (Granular) SBK (Subangular Blocky) ABK (Angular Blocky) PL (Platy) PR (Prismatic)
	II	SL (Sandy Loam) L (Loam)	0.8 - 0.6	0.4 - 0.3		
	III	Si (Silt) SiCL (Silty Clay Loam) CL (Clay Loam) SCL (Sandy Clay Loam) SiL (Silt Loam)	0.6 - 0.3	0.3 - 0.15		
					MOIST	**WET**
	IV	SC (Sandy Clay) SiC (Silty Clay) C (Clay)	0.4 - 0.1	0.2 - 0.05	VFR (Very Friable) FR (Friable) FI (Firm) VFI (Very Firm v. Very Sticky) EFI (Extremely Firm)	NS (Non-sticky) SS (Slightly Sticky) S (Sticky) VS (Very Sticky) NP (Non-plastic) SP (Slightly Plastic) P (Plastic) VP (Very Plastic)
		O (Organic)	None	None		

*Adjust LTAR due to depth, consistence, structure, soil wetness, landscape, position, wastewater flow and quality.


NOTES

HORIZON DEPTH	In inches below natural soil surface
DEPTH OF FILL	In inches from land surface
RESTRICTIVE HORIZON	Thickness and depth from land surface
SAPROLITE	S(suitable) or U(unsuitable)
SOIL WETNESS	Inches from land surface to free water or inches from land surface to soil colors with chroma 2 or less - record Munsell color chip designation
CLASSIFICATION	S (Suitable), PS (Provisionally Suitable), or U (Unsuitable)

Evaluation of saprolite shall be by pits.

Long-term Acceptance Rate (LTAR): gal/day/ft^2

Show profile locations and other site features (dimensions, reference or benchmark, and North).

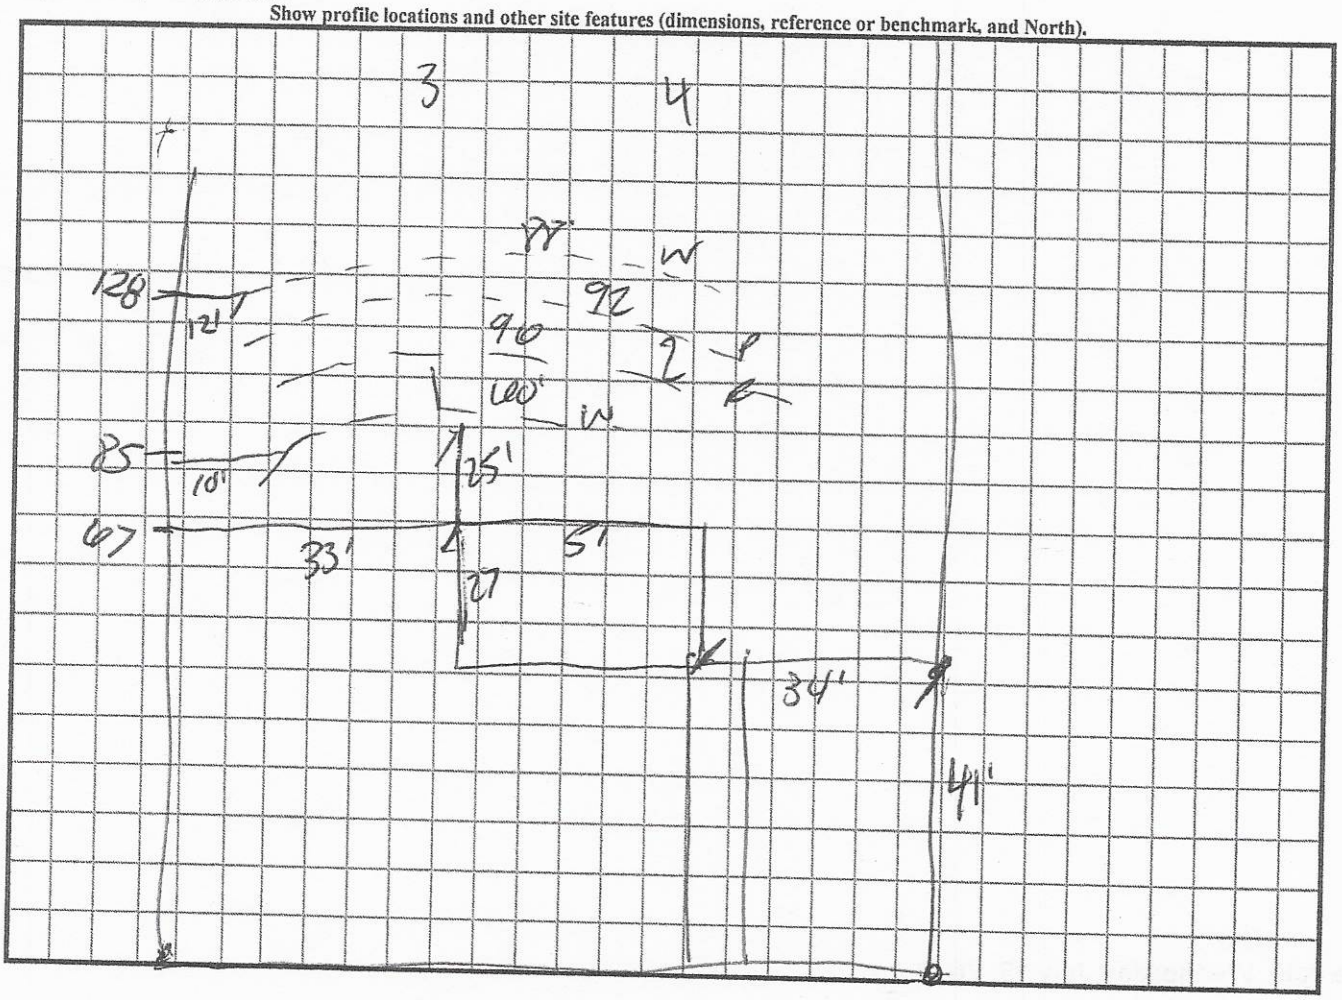

Grassy Meadows

4 not market

RECEIVED APR 2 8 2020

AP-306781
$300.00

APPLICATION MUST BE FILLED OUT COMPLETELY & LEGIBLE
OR IT WILL NOT BE PROCESSED

Lot 60

Iredell County Health Department – Environmental Health Division

PAGE 1: *APPLICATION FORM*

Application For:
( ) New Well Permit ( ) Well Repair Permit ( ) Well Abandonment
(✓) Septic Improvement Permit (✓) Authorization to Construct ( ) Existing System Inspection ( ) Septic System Repair

THE ABOVE PERMIT DOCUMENTS WILL BECOME INVALID IF INFORMATION PROVIDED ON THIS APPLICATION IS FALSIFIED OR CHANGED, OR IF THE SITE IS ALTERED. THE IMPROVEMENT PERMIT IS VALID FOR EITHER 60 MONTHS OR WITHOUT EXPIRATION DEPENDING UPON DOCUMENTATION SUBMITTED. APPLICATION WITH SITE PLAN 60 MONTHS, APPLICATION WITH COMPLETE, SCALED PLAT WITHOUT EXPIRATION
SEE 15A NCAC 18A .1937(b) FOR DETAILS

Page 2: *Site Plan Worksheet* form MUST accompany this application

The following optional attachments may also be submitted: ( ) Survey Plat, scaled no more than 1 inch = 60 feet
Place an (X) beside whichever is submitted if applicable ( ) Custom Site Plan, scaled [illegible]

Applicant Information: (PRINT CLEARLY)

Applicant Name: Dixieland Inc Address: 133 Redemption Rd S-Ville, NC 28625 Zip: 28625
Applicant Email: gingerdowdle2@gmail.com Phone: 704-202-4971 Alt. Phone:
Owner Name: [illegible] Address: [illegible] Zip:
Owner Email: lmcdowell@klwestern.com Phone: 336 302-9225 Alt. Phone:

Property Information:

Street Address: 233 Grassy Meadow Ln Statesville, NC 28625
Subdivision Name: Ridgecrest Section/Phase: Lot Number: 60
Driving Directions: 115N to Right on Branchward - TL on Riverfield TR on Grassy Meadow - Lot on Right

(✓) All that apply — CHECK FOUNDATION TYPE

(✓) New Single Family Residence — Maximum Number of Bedrooms: 3 — (✓) Crawl Space Foundation
( ) New Multi-Family Residence — Maximum Number of Occupants: 6 — ( ) Concrete Slab Foundation
( ) Accessory Building — ( ) Swimming Pool — ( ) Basement with Plumbing
( ) Bedroom(s) Addition — ( ) Other Addition/Structure: — ( ) Basement without Plumbing
( ) Repair to failing septic system ___ Tank ___ Drain lines Describe Problem:
Non-Residential Site Development: Type of Business:
Square Footage of Building: Max. Number of Employees: Max. Number of Seats/Beds/Other:

Water Supply: ( ) Replacement Well – Reason:

( ) New Well ( ) Existing Well ( ) Community Well ( ) City Water (✓) Other Public Water

Desired Septic System Type: *(you may rank in order of preference)* Year existing system installed:
( ) No Preference ( ) Alternative (1) Conventional ( ) Innovative (2) Modified Conventional ( ) Other:

Please answer the following to the best of your ability:
( ) Yes (✓) No Does the site contain any jurisdictional wetlands?
( ) Yes (✓) No Is any non-domestic sewage (i.e. industrial) to be generated?
( ) Yes (✓) No Is the site subject to approval by any other public agency?

I have read this application and certify that the information provided herein is true, complete, and correct. Authorized county and state officials are granted right of entry to conduct necessary inspections to determine compliance with applicable laws and rules. I understand that I am solely responsible for the proper identification and labeling of all property lines and corners and making the site accessible so that a complete site evaluation can be performed.

Signature: Regina C Dowdle 4/21/2020
Property owner or owner's legal representative signature (SIGNATURE REQUIRED) DATE


Lot 60

IREDELL COUNTY HEALTH DEPARTMENT

ENVIRONMENTAL HEALTH DIVISION

PAGE 2: *SITE PLAN WORKSHEET*

SEE THE "SAMPLE SITE PLAN" BELOW. *INCOMPLETE SITE PLANS WILL BE RETURNED TO YOU FOR COMPLETION AND MAY RESULT IN A DELAY IN THE ISSUANCE OF YOUR SEPTIC SYSTEM PERMIT!!!*

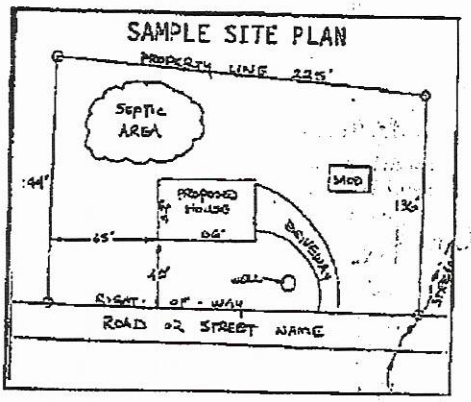

Place an (X) beside each item as you complete the site plan:

( ) Property Line measurements are clearly identified
( ) All proposed structures are indicated
( ) Front and side setbacks from property line
( ) Preferred driveway location and well location
( ) Area you prefer your septic system to be placed
( ) North arrow, or other sufficient indicator of direction

Circle N/A on the following if appropriate:

Location of septic systems and wells within 100' of your property	N/A
Location of easements and rights of ways on your property	N/A
Location of any designated wetlands on the property	N/A

USE THIS SPACE TO DRAW YOUR SITE PLAN

Show: proposed house or business footprint, wells, water lines, patios, pools and decks, and any other item that will occupy space on the site

See attached


Signature: Regina C Dowdle
Property owner or owner's legal representative signature (SIGNATURE REQUIRED)

4/21/2020
DATE

CONNECTGIS WEB HOSTING

North Carolina Iredell County

Iredell
Printed April 22, 2020
See Below for Disclaimer

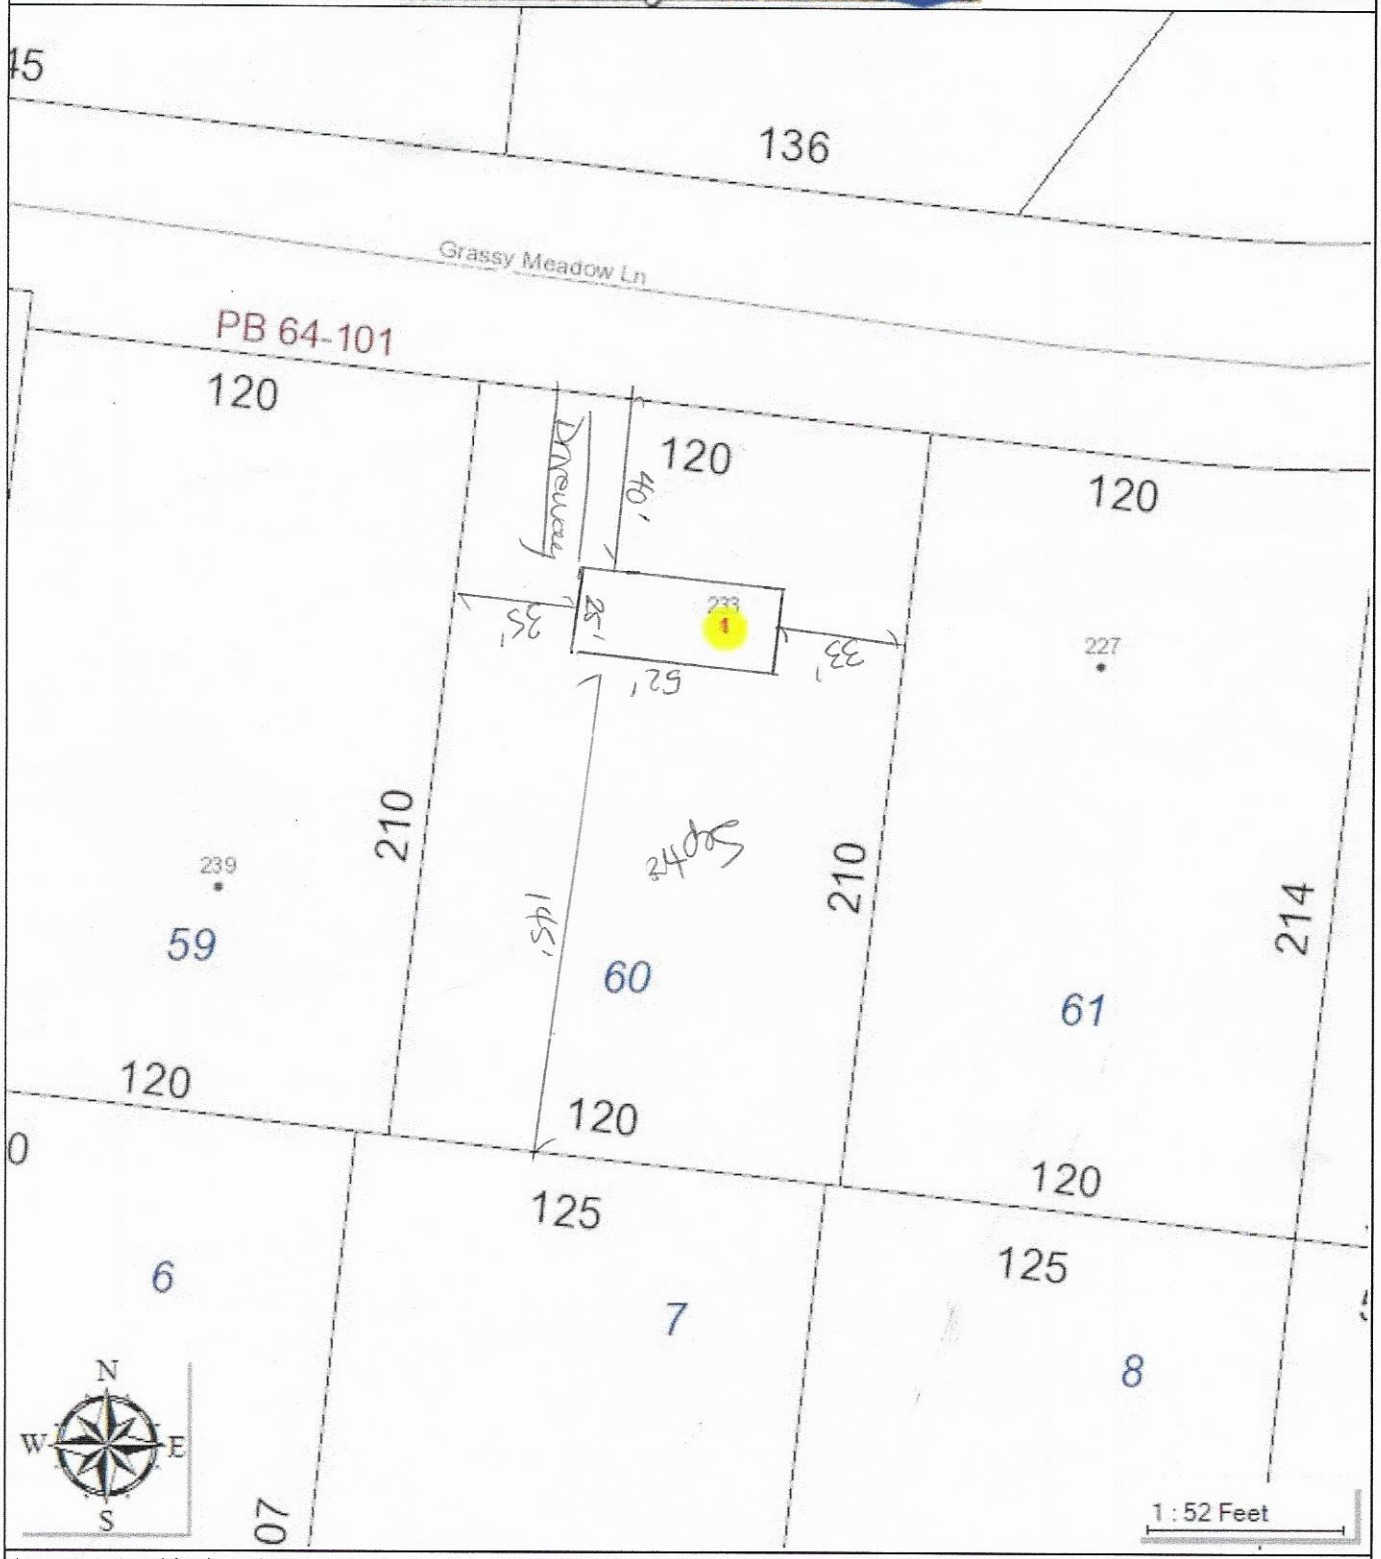

The maps prepared for this website are generated from recorded deeds, plats, and other public records. Users of these maps are hereby notified that the information provided herein should be verified. Iredell County assumes no legal responsibilities for any of the information contained on this site. Users are advised that the use of any of this information is at their own risk. All maps on this site were prepared using a 1000â€™ Grid based upon the North Carolina State Plane Coordinate System from the 1983 North American Datum. The delinquent real property tax overlay is updated monthly. The information presented is not intended to be used or relied upon as official notice of tax liens. For additional information regarding delinquent taxes, contact the Iredell County Tax Collector's Office.

07-87

Lot 60

IREDELL COUNTY DEPARTMENT OF ENVIRONMENTAL HEALTH

DOCUMENTATION TO AUTHORIZE AN OWNER'S LEGAL REPRESENTATIVE

(Check and sign only ONE of the options below)

☐ 1. * APPLICANT AND OWNER ARE THE SAME. * *(Sign here)* _____

Applications for permits require the "signature of the owner or owner's legal representative" (15A NCAC 18A .1937). If the owner does not sign the application himself or herself, they can submit any one of the following documents to designate their legal representative: *Power of Attorney; Real Estate Contract; Estate executor; Bankruptcy trustee; Court ordered guardianship*
In the absence of the above documentation, the property owner may provide the local health department with documentation that designates a legal representative. A property owner may:
Complete this form to document his or her legal representative, or provide his or her own form that contains the information in this form. If there are multiple property owners, then all property owners must sign the form that designates a legal representative.
By signing a form that designates a legal representative for purposes of 15A NCAC 18A .1937, the property owner authorizes that representative to act on their behalf in matters pertaining to the application and permitting process, including signing or receiving any application, document or permit. The owner retains full responsibility to meet all permit conditions specified by the local health department.

☑ 2. I, Ken McDowell, am the legal owner(s) of the property located at 233 Mossey Meadow, identified as PIN (Parcel Identification Number) 4727990901, located in Iredell County, North Carolina.

I do hereby authorize (print legal representative/company name) Ginger Dowdle / Dixieland Inc., to act as an agent on my behalf in applying for/signing/obtaining any of the documents described below.

- Application for Improvement Permit (IP) / Authorization to Construct (AC)
- Improvement Permit (IP) / Authorization to Construct (AC)
- Application for soil-site evaluation (new/repair)
- Application/permit for private drinking water well/well abandonment
- Application for Compliance Inspection

I agree to abide by all decisions and/or conditions between the legal representative acting on my behalf and the Iredell County Department of Public Health, Environmental Health Division.


Ken McDowell
Signature of Owner(s)

2-22-20
Date

Mooresville - Environmental Health
Fax: 704-662-3239
610 E. Center Avenue, Mooresville, NC 28115

Statesville - Environmental Health
ronda.hart@co.iredell.nc.us
Fax: 704-871-3483
349 N. Center Street, Statesville, NC 28677


Regina C Dawdle
Call C. Neese 6-1-20

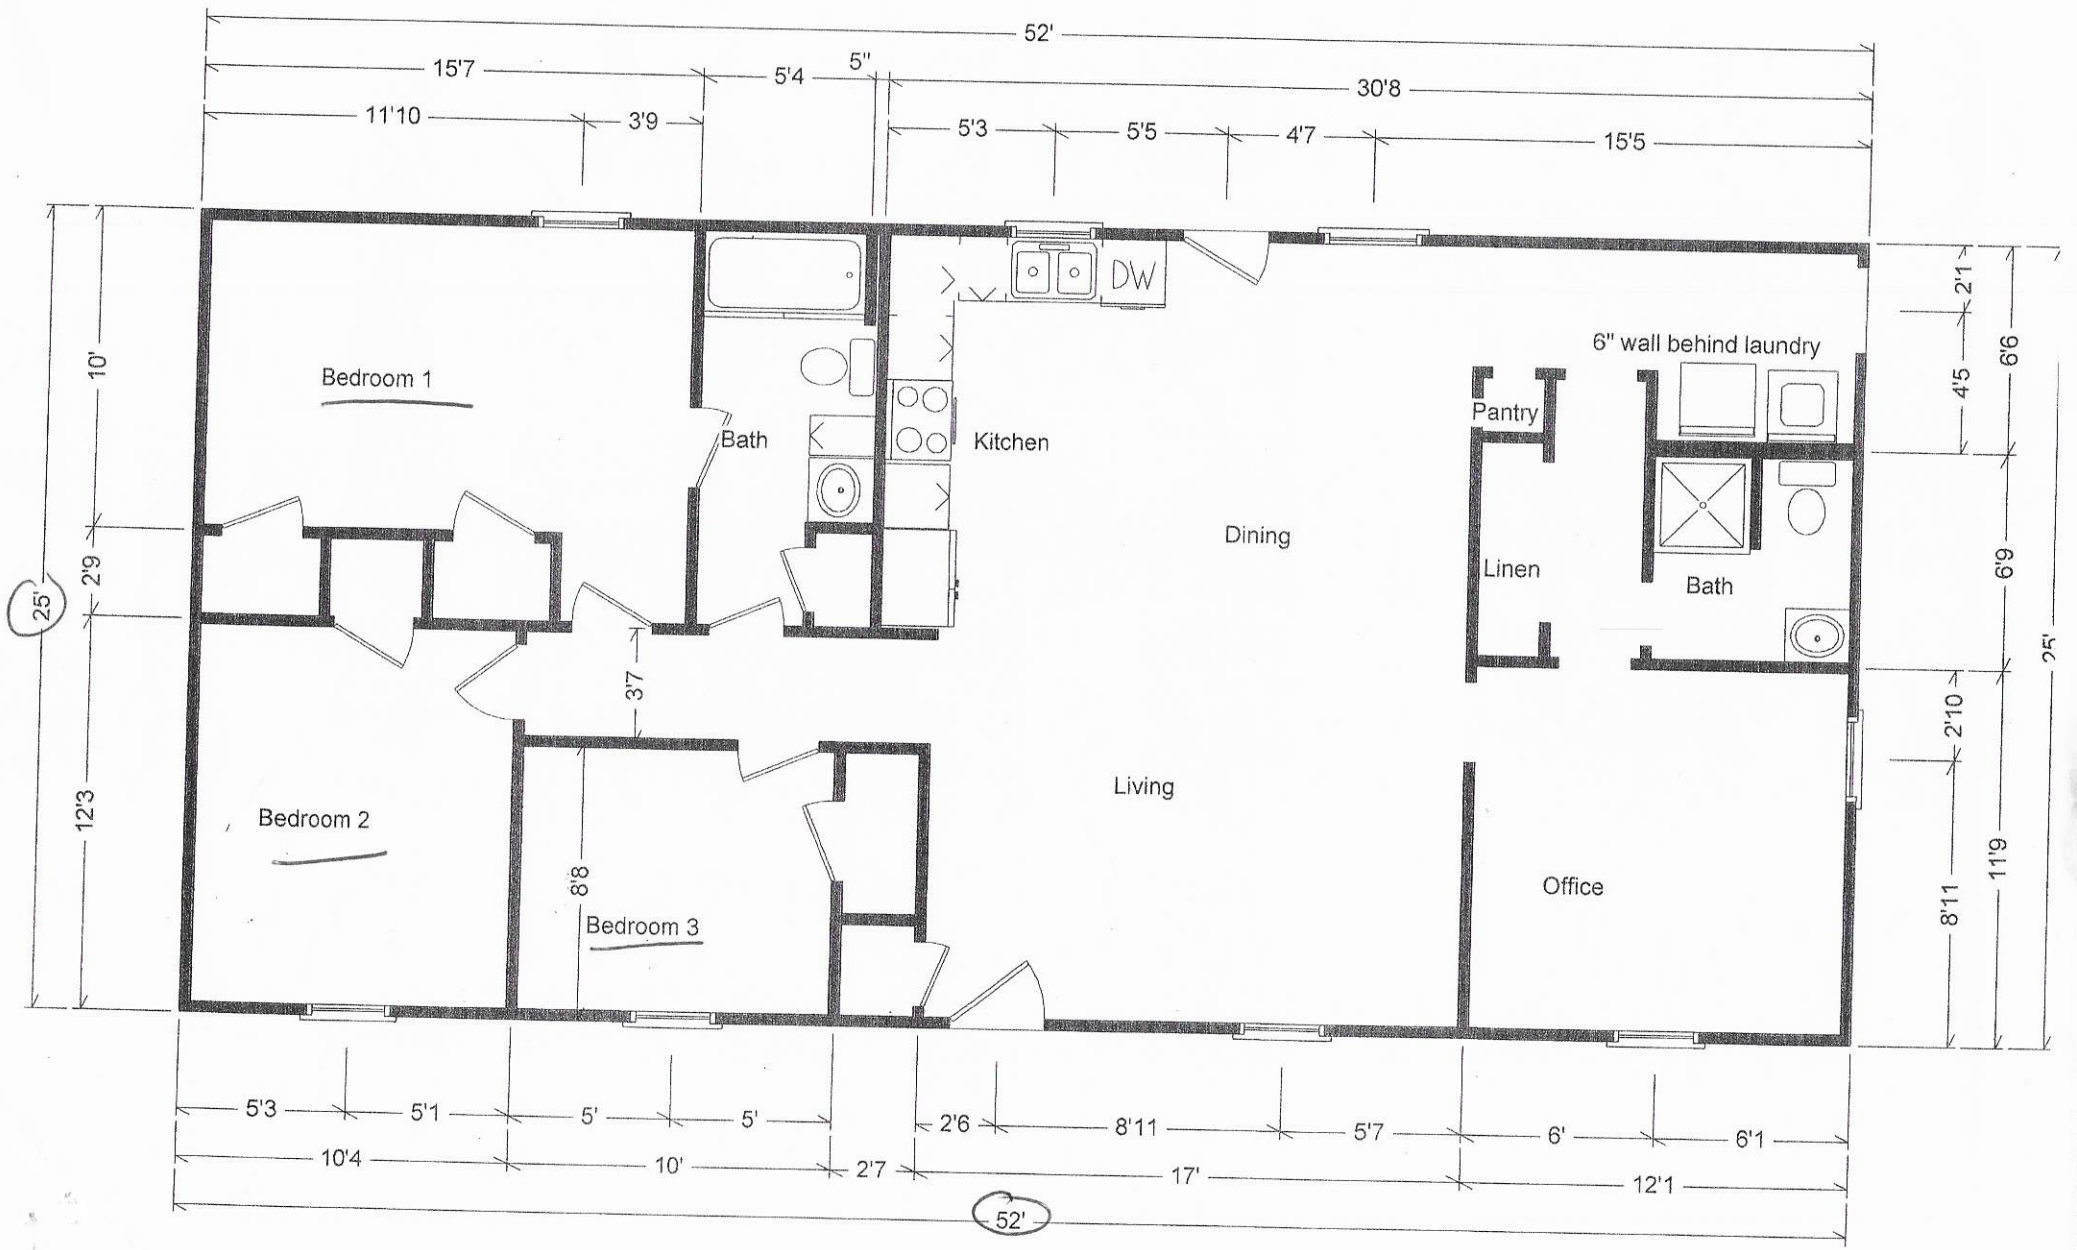

Ridgecrest Lot 60

233 Grassy Meadow

ZONING DISCLAIMER

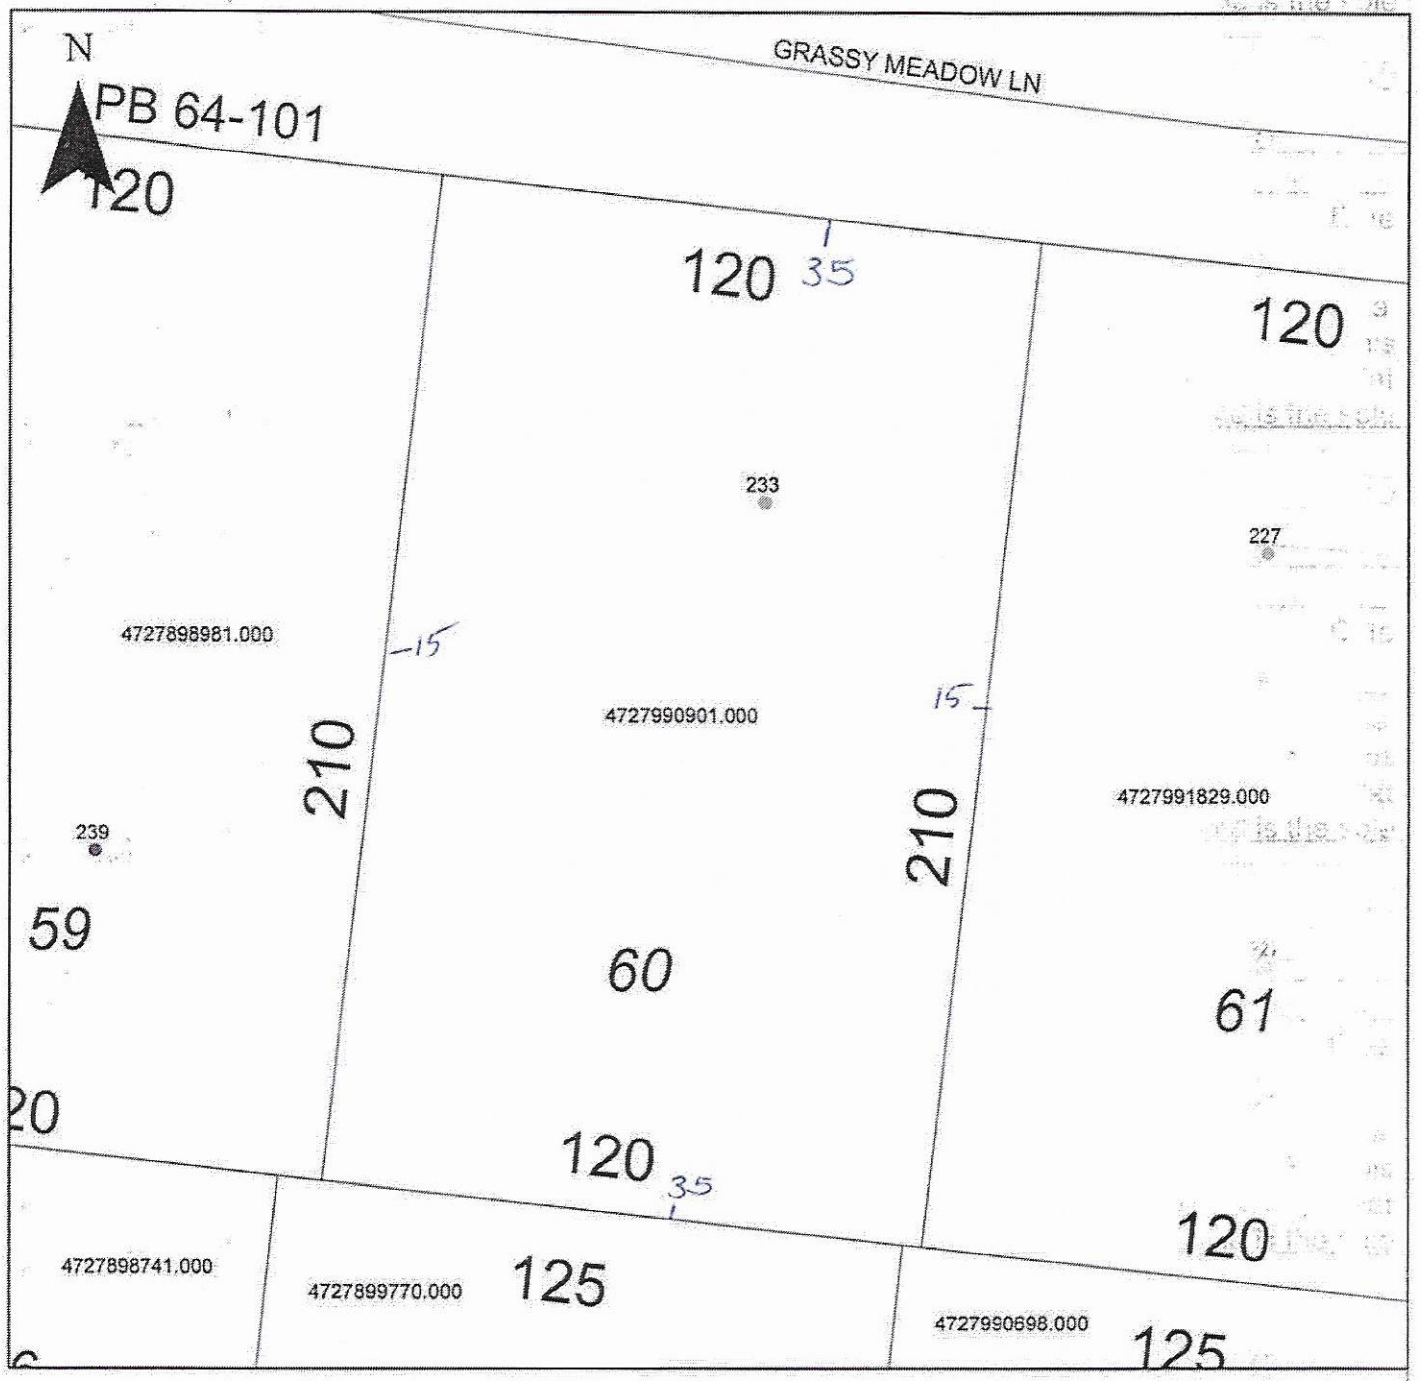

Property Address 233 Grassy Meadow

The applicant certifies that there are no deed restrictions, contractual agreements or governmental regulations of any kind that interfere with or prohibit the use of the property or the use for which this permit is requested. Applicant further acknowledges that the enforcement of deed restrictions, plat conditions, and other contractual agreements will not be undertaken by Iredell County and is the sole responsibility of the affected parties.

Applicant

Date