IREDELL COUNTY HEALTH DEPARTMENT

STATESVILLE 704-878-5305 MOORESVILLE 704-664-5281

IMPROVEMENT PERMIT / CERTIFICATE OF COMPLETION / OPERATION PERMIT / EXISTING SYSTEM INSPECTION

PROPERTY DESCRIPTION NO. 18518 DATE 5/24/94 TAX MAP NO. 10E-A-46 (PART OF) Watershed: ☐ Yes ☑ No

OWNER OR CONTRACTOR WAYNE JOHNSTON PHONE: Business Home 876-6781

ADDRESS RT. 11 BOX 386-C STL, NC 28677

LOCATION NC115N, TR BRANCHWOOD ROAD (SR 1908) ON (R) PAST YADKIN VALLEY RD ~ 0.3 MI

SUBDIVISION BLOCK / SECTION LOT LOT AREA ~150'X262' SITE CLASS. PS DESIGN FLOW 360 L.T.A/R. 0.30 GPD/FT²

Septic Tank: 1000 Gallons; STB 1012 Date 5/18/94

Pump Tank: Gallons; PT Date

Pump Make: Model Serial No.

Nitrification Field: No Fields 1 Square Feet 1200 Linear Feet 400

No Lines 3 Trench Width 36" Max Trench Bottom Depth 18-36" Gravel Depth 12"

☑ New System ☐ Repair System Type: I, II, III, IV, V, VI

System Description: CONVENTIONAL GRAVITY

Repair System Description: CONV. GRAVITY

Maintenance Agreement Required: ☐ Yes ☑ No

☑ House/Mod. Home No. Bedrooms 3

☐ Mobile Home No. Bathrooms 2

☐ Business No. Employees

☐ Other


☐ Slab ☑ Crawl Space ☐ Basement w/plumbing ☐ Basement wo/plumbing

Water Supply: ☐ Individual ☐ Community ☑ Public

Comments: (1) KEEP SYSTEM MINIMUM 5' FROM HOUSE 10' FROM PROPERTY LINE, 10' FROM WATER LINE (2) INSTALL LINES ON CONTOUR, NO DEEPER THAN 36', 9' APART ON CENTER.

Comments:

INITIAL SITE SKETCH

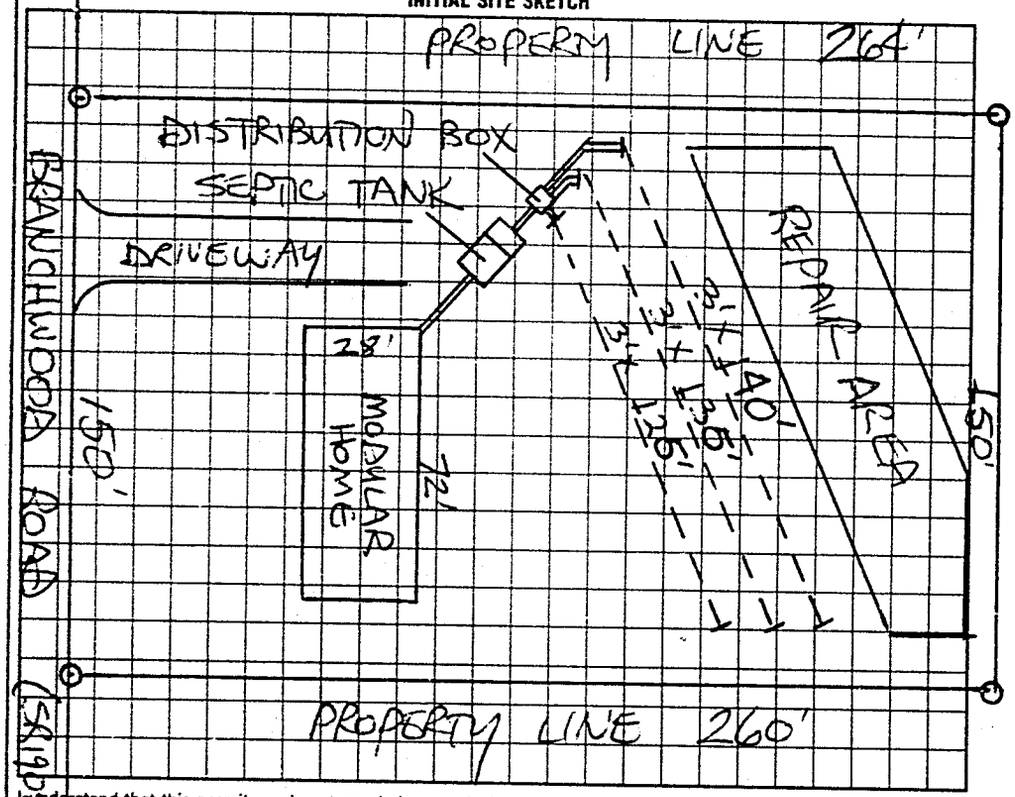

AS BUILT SKETCH

SYSTEM INSTALLED ACCORDING TO INITIAL SITE SKETCH

I understand that this permit can be suspended or revoked if any false information is supplied toward securing the permit/any unauthorized changes are made to the site/any unauthorized changes are made in the installation of the system. Improvement Permit is valid for 60 months from date of issuance.

Signed: X Wayne Johnston

Improvement Permit by: STEVE HEDRICK date 5/24/94

Existing System Inspection by: date

Installed by: HARRY REED

Certificate of Completion by: STEVE HEDRICK date 7/21/94

Operation Permit by: date

HEALTH DEPT. COPY: WHITE INSPECTION COPY (FINAL): GREEN OWNER COPY (FINAL): YELLOW INSPECTION COPY (INITIAL): PINK OWNER COPY (INITIAL): GOLD

092100