IREDELL COUNTY HEALTH DEPARTMENT

STATESVILLE 704-878-5305 MOORESVILLE 704-664-5281

IMPROVEMENT PERMIT / CERTIFICATE OF COMPLETION / OPERATION PERMIT / EXISTING SYSTEM INSPECTION

PROPERTY DESCRIPTION NO. 25983 DATE 2-4-97 TAX MAP NO. 4738 CO 6849 Watershed: ☐ PA ☐ WS-I ☐ WS-II ☐ No

OWNER OR CONTRACTOR CRAVEN, KEARNS, McDOWELL PHONE: Business (910) 672-2269 Home

ADDRESS P.O. BOX 2257 ASHEBORO, NC 27204

LOCATION NC 115 N, TR BRANCHWOOD RD, ON LEFT PAST YADKIN VALLEY RD

SUBDIVISION RIDGECREST BLOCK / SECTION LOT 10 LOT AREA 0.721 ACRES SITE CLASS PS DESIGN FLOW 360 L.T.A.R. 0.30 GPD/FT²

Septic Tank: 1000 Gallons; STB 1012 Date 11-4-96

Pump Tank: Gallons; PT Date

Pump Make: Model Serial No.

Nitrification Field: No Fields 1 Square Feet EQ. 1200 Linear Feet 300'

No Lines FIVE Trench Width 36" Max Trench Bottom Depth 36"

☑ New System ☐ Repair System Type: I, II, III, IV, V, VI

System Description: CHAMBERED, GRAVITY

Repair System Description: CONVENTIONAL PUMP

Maintenance Agreement Required: ☐ Yes ☑ No

Gravel Depth N/A ☐ Slab ☑ Crawl Space ☐ Basement w/plumbing ☐ Basement wo/plumbing

☐ House/Mod. Home ☑ Mobile Home ☐ Business ☐ Other


No. Bedrooms 3 No. Bathrooms 2 No. Employees

Water Supply: ☐ Individual ☐ Community ☑ Public

Comments: INSTALL 50 CHAMBERS IN FIVE EQUAL LENGTH LINES ON CONTOUR AS FLAGGED

Comments:

INITIAL SITE SKETCH

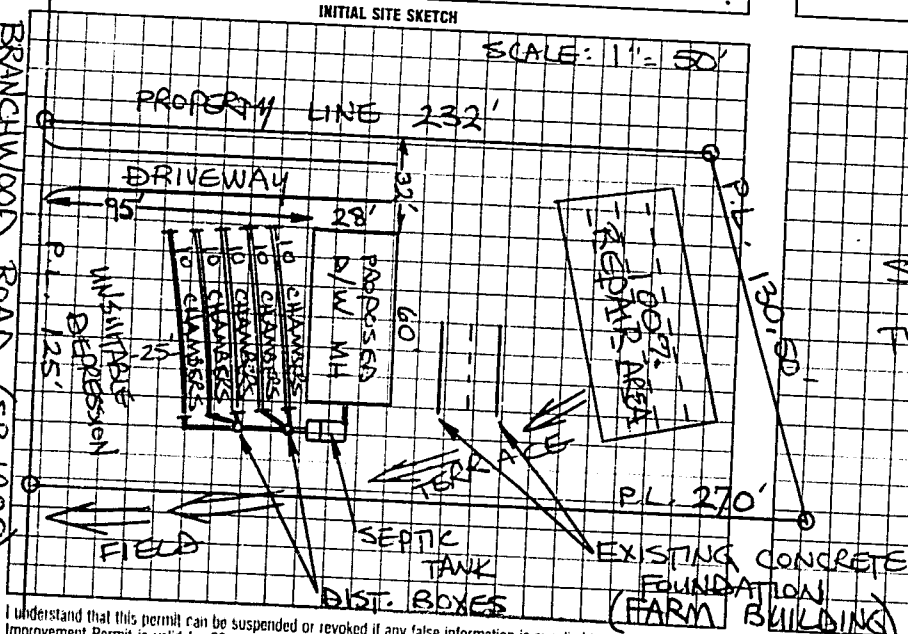

AS BUILT SKETCH

SYSTEM INSTALLED ACCORDING TO INITIAL SITE SKETCH

I understand that this permit can be suspended or revoked if any false information is supplied toward securing the permit/any unauthorized changes are made to the site/any unauthorized changes are made in the installation of the system. Improvement Permit is valid for 60 months from date of issuance. AUTHORIZATION TO CONSTRUCT IS VALID FOR 60 MONTHS FROM ISSUANCE.

Signed: [signature]

Improvement Permit by: STEVE HEDRICK date 2-4-97

AUTH. TO CONST

~~Existing System Inspection by:~~ STEVE HEDRICK date 2-4-97

Installed by: A-1 BACKHOE

~~Certificate of Completion by:~~ date

Operation Permit by: STEVE HEDRICK date 11-4-97

HEALTH DEPT. COPY WHITE INSPECTION COPY (FINAL) GREEN OWNER COPY (FINAL) YELLOW INSPECTION COPY (INITIAL) PINK OWNER COPY (INITIAL) GOLD