IREDELL COUNTY HEALTH DEPARTMENT

STATESVILLE 704-878-5305 MOORESVILLE 704-664-5281

IMPROVEMENT PERMIT / CERTIFICATE OF COMPLETION / OPERATION PERMIT / EXISTING SYSTEM INSPECTION

PROPERTY DESCRIPTION NO. 25984 DATE 2-4-97

OWNER OR CONTRACTOR CRAVEN, KEARNS, MCDOWELL PIN/MAP NO. 4738 00 6849

ADDRESS P.O. BOX 2257 ASHEBORO NC 27204 PHONE: Business (910) 672-2268 Home

Watershed: ☐ Yes ☑ No

LOCATION NC 115 N, TR BRANCHWOOD RD, LOT #11 ON LEFT PAST YADKIN VALLEY ROAD

SUBDIVISION RIDGECREST BLOCK / SECTION LOT 11 LOT AREA 0.713 ACRE SITE CLASS. PS DESIGN FLOW 360 L.T.A.R. 0.30 GPD/FT²

Septic Tank: 1000 Gallons; STB 1012 Date 5-27-98

Pump Tank: Gallons; PT Date

Pump Make: Model Serial No.

Nitrification Field: No Fields 1 Square Feet EQ. TO 1200 Linear Feet 300

No Lines FIVE Trench Width 36" Max Trench Bottom Depth 36" Gravel Depth N/A

☑ New System ☐ Repair System Type: I, II, (III), IV, V, VI

System Description: CHAMBERED GRAVITY

Repair System Description: CONVENTIONAL PUMP

Maintenance Agreement Required: ☐ Yes ☑ No

☐ House/Mod. Home ☑ Mobile Home ☐ Business ☐ Other

No. Bedrooms 3 No. Bathrooms 2 No. Employees


☐ Slab ☑ Crawl Space ☐ Basement w/plumbing ☐ Basement wo/plumbing

Water Supply: ☐ Individual ☐ Community ☑ Public


Comments: INSTALL 50 CHAMBERS IN FIVE EQUAL LENGTH LINES ON CONTOUR AS FLAGGED

Comments:

INITIAL SITE SKETCH

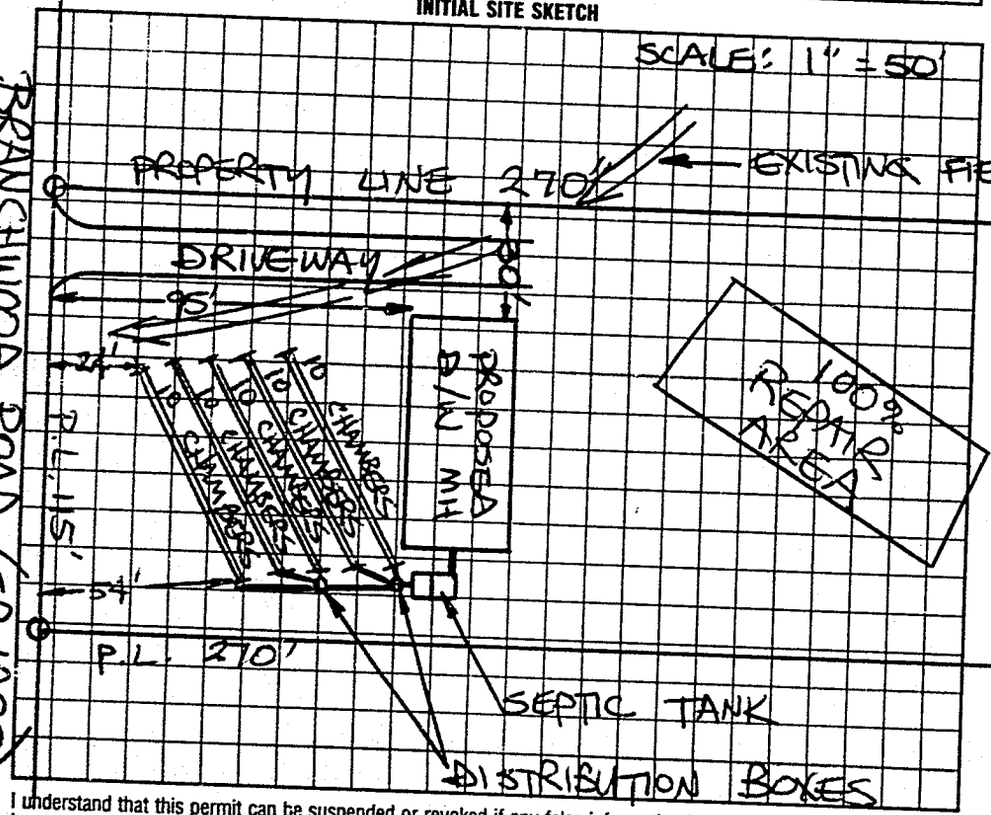

AS BUILT SKETCH

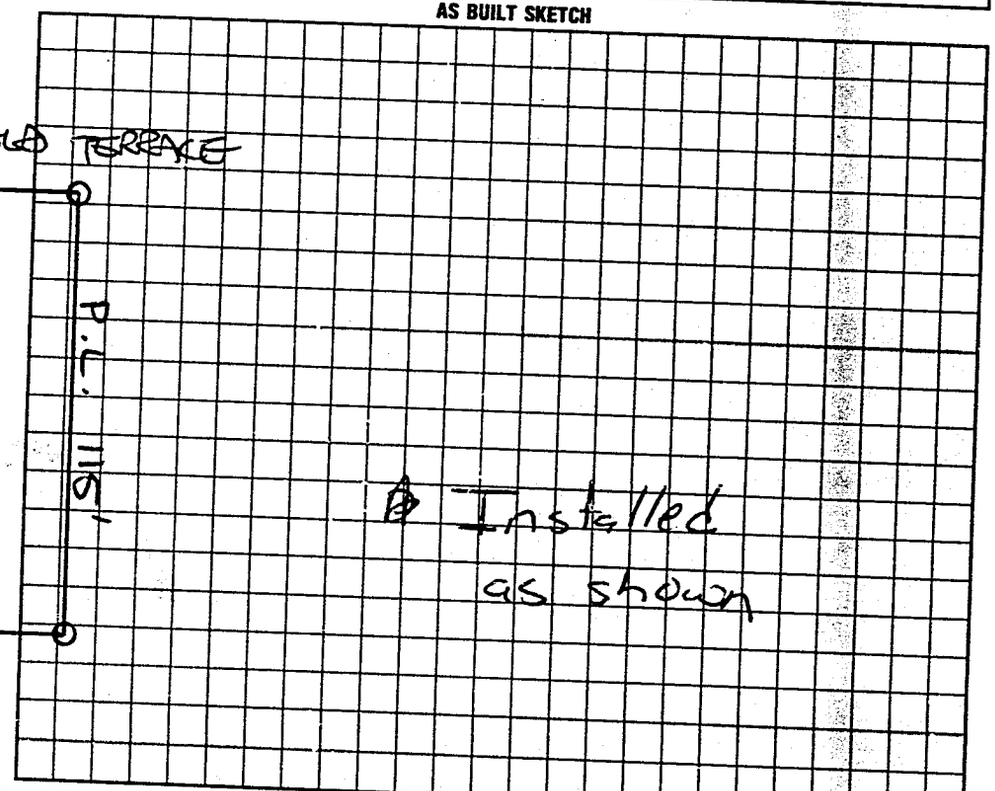

I understand that this permit can be suspended or revoked if any false information is supplied toward securing the permit/any unauthorized changes are made to the site/any unauthorized changes are made in the installation of the system. Improvement Permit is valid for 60 months from date of issuance. AUTHORIZATION TO CONSTRUCT IS VALID FOR 60 MONTHS FROM DATE OF ISSUANCE.

Signed: Phil Craven

Improvement Permit by: STEVE HEDRICK date 2-4-97

AUTH. TO CONST

~~Existing System Inspection by:~~ STEVE HEDRICK date 2-4-97

Installed by: A-1 Backhoe

~~Certificate of Completion by:~~ date

Operation Permit by: Matt COX RS date 8-3-98

HEALTH DEPT. COPY: WHITE INSPECTION COPY (FINAL): GREEN OWNER COPY (FINAL): YELLOW INSPECTION COPY (INITIAL): PINK OWNER COPY (INITIAL): GOLD