IREDELL COUNTY HEALTH DEPARTMENT

STATESVILLE 704-878-5305 MOORESVILLE 704-664-5281

IMPROVEMENT PERMIT / AUTHORIZATION TO CONSTRUCT / OPERATION PERMIT / EXISTING SYSTEM INSPECTION

PERMIT# 86540 PIN# 4738003365 PT DATE 12-3-99

OWNER OR CONTRACTOR Craven, Hearns, ETAL PHONE: Business 872 6645 Home

ADDRESS 374 Long Island Rd Statesville N.C.

LOCATION 115 N TR 8 Branchwood TL Riverfield TR Grassy meadows On Rt

SUBDIVISION Ridgecrest BLOCK / SECTION 3 LOT 64 LOT AREA 1.63 acres SITE CLASS PS DESIGN FLOW 360 L.T.A.R. .13 gal/sq ft/day

Septic Tank: 1000 Gallons; STB 1012 Date 10-23-99
Pump Tank: ____ Gallons; PT ____ Date ____
Pump Make: ____ Model ____ Serial No. ____
Nitrification Field: No Fields 1 Square Feet 1200 Linear Feet 400
No Lines 4 Trench Width 36" Max Trench Bottom Depth 36" Gravel Depth 12"

☑ New System ☐ Repair System Type: I II III IV V VI
System Description: Conv. Gravity
Repair System Description: " " "
Maintenance Agreement Required: ☐ Yes ☑ No
☐ Slab ☐ Crawl Space ☐ Basement w/plumbing ☐ Basement wo/plumbing


☐ House/Mod. Home No. Bedrooms 3
☑ Mobile Home No. Bathrooms 2
☐ Business No. Employees ____
☐ Other ____

Water Supply: ☐ Individual ☑ Public ☐ Community


Comments/Conditions:

Comments/Conditions: SEPTIC TANK WITH RISERS INSTALLED USING "POLYLOK" FILTER

INITIAL SITE SKETCH

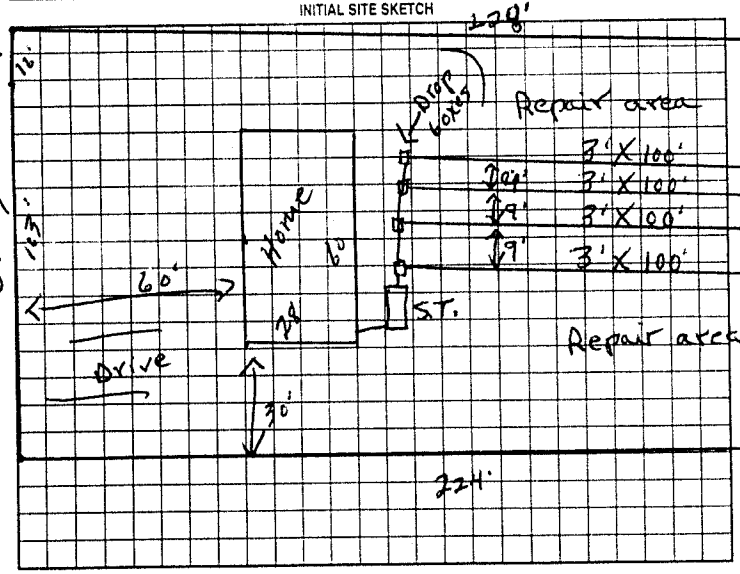

AS BUILT SKETCH

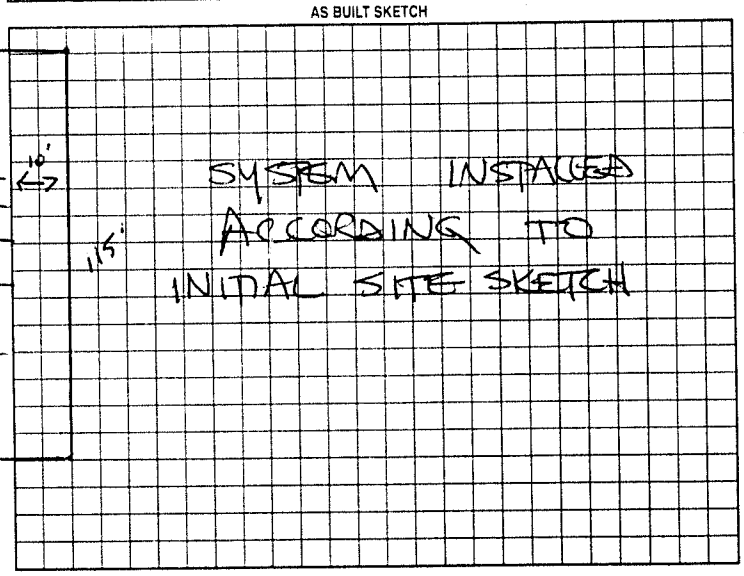

Permit can be suspended or revoked if any false information is supplied toward securing the permit/any unauthorized changes are made to the site/any unauthorized changes are made in the installation of the system. Improvement Permit with plot valid without expiration. Improvement Permit with site plan valid for sixty months. Authorization to Construct is valid for a period equal to that of Improvement Permit – not to exceed sixty months.

Signed: ____ date 6 Dec 99 Installed by: A-1 BACKHOE

Improvement Permit by: P. C. Moore date 12-3-99 Operation Permit by: STEVE HENDRICK date 2-21-00

Authorization to Construct by: P. C. Moore date 12-3-99 Existing System Inspection by: ____ date ____

HEALTH DEPT COPY WHITE OWNER COPY (FINAL) YELLOW OWNER COPY (INITIAL) PINK