IREDELL COUNTY HEALTH DEPARTMENT

STATESVILLE 704-878-5305 MOORESVILLE 704-664-5281

IMPROVEMENT PERMIT / CERTIFICATE OF COMPLETION / OPERATION PERMIT / EXISTING SYSTEM INSPECTION

PROPERTY DESCRIPTION NO. 25985 DATE 2-4-97 PIN/MAP NO. 4738 00 6849 Watershed: ☒ PA ☐ No

OWNER OR CONTRACTOR CRAVEN, KEARNS, McDOWELL PHONE: Business (910) 672-2269 Home

ADDRESS P.O. BOX 2257 ASHEBORO, NC 27204

LOCATION NC 115 N, TR BRANCHWOOD RD, ON LEFT PAST YADKIN VALLEY ROAD

SUBDIVISION RIDGECREST BLOCK / SECTION LOT 12 LOT AREA 120' X 270' SITE CLASS. PS DESIGN FLOW 360 L.T.A.R. 0.30 GPD/FT2

Septic Tank: 1000 Gallons; STB 1012 Date 11-4-96

Pump Tank: Gallons; PT Date

Pump Make: Model Serial No.

Nitrification Field: No Fields 1 Square Feet 1200 Linear Feet 400

No Lines FIVE Trench Width 36" Max Trench Bottom Depth 36" Gravel Depth 12"

☒ New System ☐ Repair System Type: I, II, III, IV, V, VI

System Description: CONVENTIONAL GRAVITY

Repair System Description: CONVENTIONAL PUMP

Maintenance Agreement Required: ☐ Yes ☒ No

☐ House/Mod. Home No. Bedrooms 3

☒ Mobile Home No. Bathrooms 2

☐ Business No. Employees

☐ Other


☐ Slab ☒ Crawl Space ☐ Basement w/plumbing ☐ Basement wo/plumbing

Water Supply: ☐ Individual ☐ Community ☒ Public


Comments:

Comments:

INITIAL SITE SKETCH

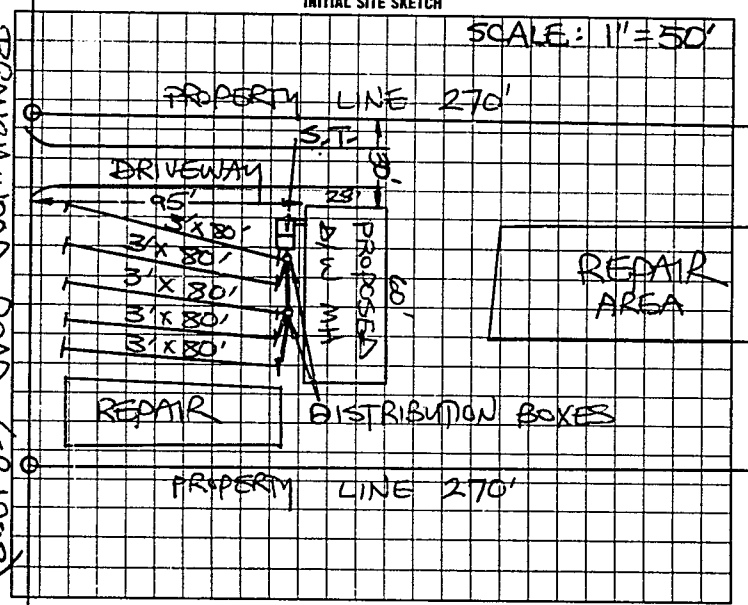

AS BUILT SKETCH

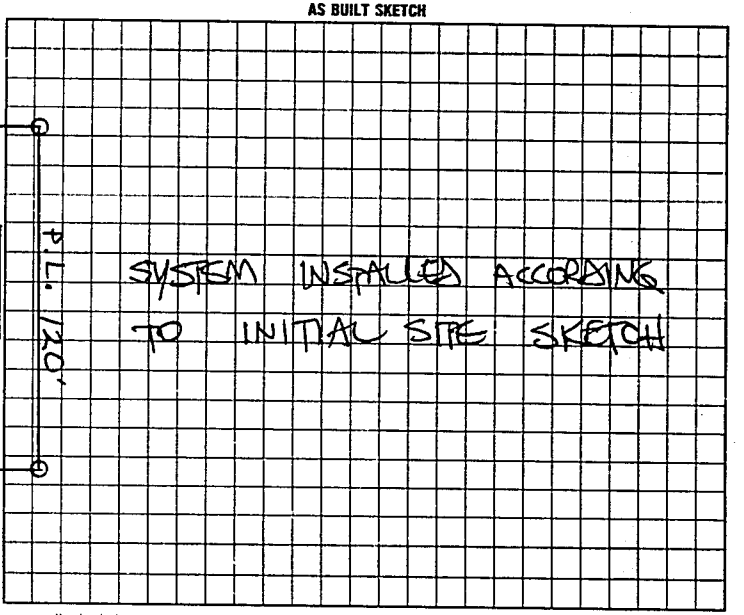

I understand that this permit can be suspended or revoked if any false information is supplied toward securing the permit/any unauthorized changes are made to the site/any unauthorized changes are made in the installation of the system. Improvement Permit is valid for 60 months from date of issuance. AUTHORIZATION TO CONSTRUCT IS VALID FOR 60 MONTHS FROM DATE OF ISSUANCE.

Signed: Phil Craven

Improvement Permit by: STEVE HEDRICK date 2-4-97

AMPT - TO CONST. Existing System Inspection by: STEVE HEDRICK date 2-4-97

Installed by: A-1 BACKHOE

~~Certificate of Completion by:~~ date

Operation Permit by: STEVE HEDRICK date 11-4-97

HEALTH DEPT. COPY WHITE INSPECTION COPY (FINAL) GREEN OWNER COPY (FINAL) YELLOW INSPECTION COPY (INITIAL) PINK OWNER COPY (INITIAL) GOLD

9 Σ Σ 0 0 0