IREDELL COUNTY HEALTH DEPARTMENT

STATESVILLE 704-878-5305 (@) MOORESVILLE 704-664-5281

IMPROVEMENT PERMIT / AUTHORIZATION TO CONSTRUCT / OPERATION PERMIT / EXISTING SYSTEM INSPECTION

PERMIT # 159696 PIN # 4717-99-7888 8827 DATE 15 Apr. 10

OWNER or APPLICANT Stephen J. Eagles PHONE: Business (704) 873-4121 Home: 704/876-2351

OWNER or APPLICANT ADDRESS 407 Cove Gap Rd. Statesville

LOCATION / DIRECTIONS 115N TL Midway Rd. TR Cove Gap Rd. S.R on Rt.

SUBDIVISION BLOCK / SECTION LOT # LOT AREA DESIGN FLOW 240 gpd L.T.A.R. 0.3 gpd/ft²

Septic Tank 1000 Gallons: STB 794 Date 3-25-10

Pump Tank Gallons: PT Date

Pump Make Model Serial #

Nitrification Field No Fields 1 No Lines 2 Linear Feet 200

Trench Width 36" Max. Trench Bottom Depth 36" Gravel Depth NA

☑ New System ☐ Repair ☐ Expansion System Type I II (III) IV V VI

System Description: 25% Reductive

Repair System Description: 25% Reduction

Maintenance Agreement Required ☐ YES ☑ NO

☑ GRAVITY ☐ PRESSURE

☑ Residence No. Bedrooms 2 ☐ Business No. Persons ☐ Other No. Employees


☑ Slab ☑ Crawl Space ☐ Basement w/plumbing ☐ Basement w/o plumbing

Water Supply: ☑ Private ☐ Public ☐ Community

Comments / Conditions * Keep well 100' from system and repair Areas / Follow contour /

Comments / Conditions Filter installed. SI marker.

INITIAL SITE SKETCH

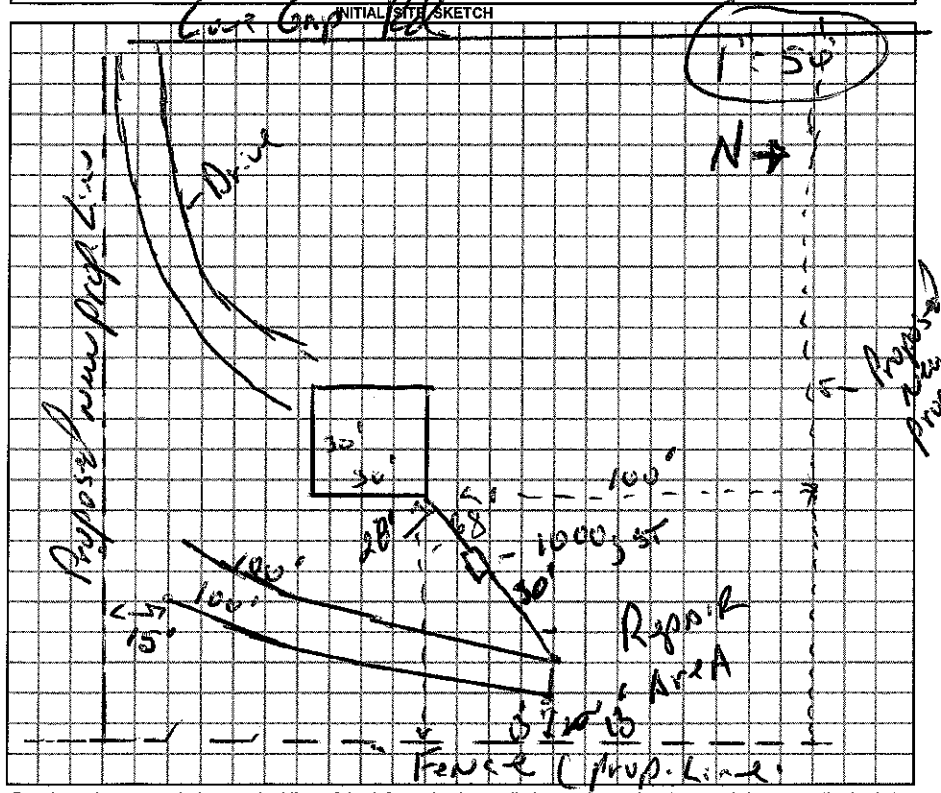

AS BUILT SKETCH

Installed as Drawn on site sketch

Permit can be suspended or revoked if any false information is supplied toward securing the permit / any unauthorized changes are made to the site / any unauthorized changes are made in the installation of the system.

☐ *IMPROVEMENT PERMIT w / plat valid without expiration.* ☑ *IMPROVEMENT PERMIT w / site plan valid for 60 mos.* ☑ *AUTHORIZATION TO CONSTRUCT valid for period equal to IMPROVEMENT PERMIT-not to exceed 60 mo.*

Owner / Applicant Signature: Date 4-20-10

Improvement Permit by: R.S. Date 15 Apr. 10

Authorzation to Construct by: R.S. Date 15 Apr. 10

Installed by: James Holder

Operation Permit by: R.S. Date: 31 Aug. 10

Existing System Inspected by: Date:

YOU SHOULD CONTACT A LOCATOR SERVICE PRIOR TO ANY EXCAVATION.

WHITE COPY Environmental Health YELLOW COPY (Final) Owner / Applicant PINK COPY (Initial) Owner / Applicant