IREDELL COUNTY HEALTH DEPARTMENT

STATESVILLE 704-878-5305 MOORESVILLE 704-664-5281

IMPROVEMENT PERMIT / AUTHORIZATION TO CONSTRUCT / OPERATION PERMIT / EXISTING SYSTEM INSPECTION

PERMIT# 114027 PIN# 4728-02-0654 DATE 7-15-03

OWNER OR CONTRACTOR TERRY O'BRIEN PHONE: Business 704-876-8600 Home

ADDRESS 310 TREEBARK LANE, STATESVILLE, NC 28625

LOCATION NC 115 N, TL PISGAH CH RD, TL TREEBARK RD, TR HIDDEN RIVER LANE, 2ND LOT ON LEFT

SUBDIVISION HIDDEN RIVER BLOCK / SECTION LOT 12 LOT AREA 3.07 ACRES SITE CLASS. PS DESIGN FLOW 360 L.T.A.R. 0.30 GPD/FT2

Septic Tank: 1000 Gallons; STB 325 Date 10-18-01
Pump Tank: Gallons; PT Date
Pump Make: Model Serial No.
Nitrification Field: No Fields 1 Square Feet 1200 Linear Feet 400
No Lines FOUR Trench Width 36" Max Trench Bottom Depth 34" Gravel Depth 12"

☑ New System ☐ Repair System Type: I, II, III, IV, V, VI
System Description: CONVENTIONAL GRAVITY
Repair System Description: CONVENTIONAL, GRAVITY
Maintenance Agreement Required: ☐ Yes ☑ No


☑ House/Mod. Home No. Bedrooms 3
☐ Mobile Home No. Bathrooms 2.5
☐ Business No. Employees
☐ Other
☐ Slab ☑ Crawl Space ☐ Basement w/plumbing ☐ Basement wo/plumbing

Water Supply: ☑ Individual ☐ Public ☐ Community WELL


Comments:/Conditions: ① KEEP SYSTEM MINIMUM 100 FEET FROM WELL ② INSTALL DRAINLINES ON CONTOUR AS FLAGGED

Comments:/Conditions: ① BLUE POLYLOK FILTER ② TANK < 6" BELOW GRADE ③ #5 STONE

INITIAL SITE SKETCH

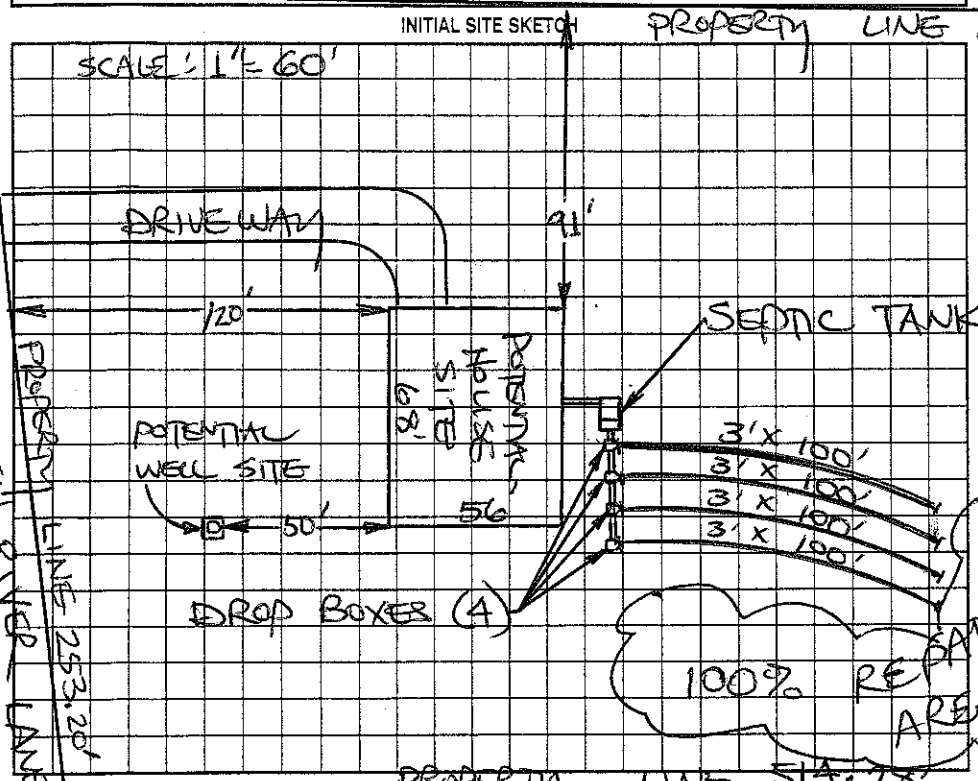

AS BUILT SKETCH

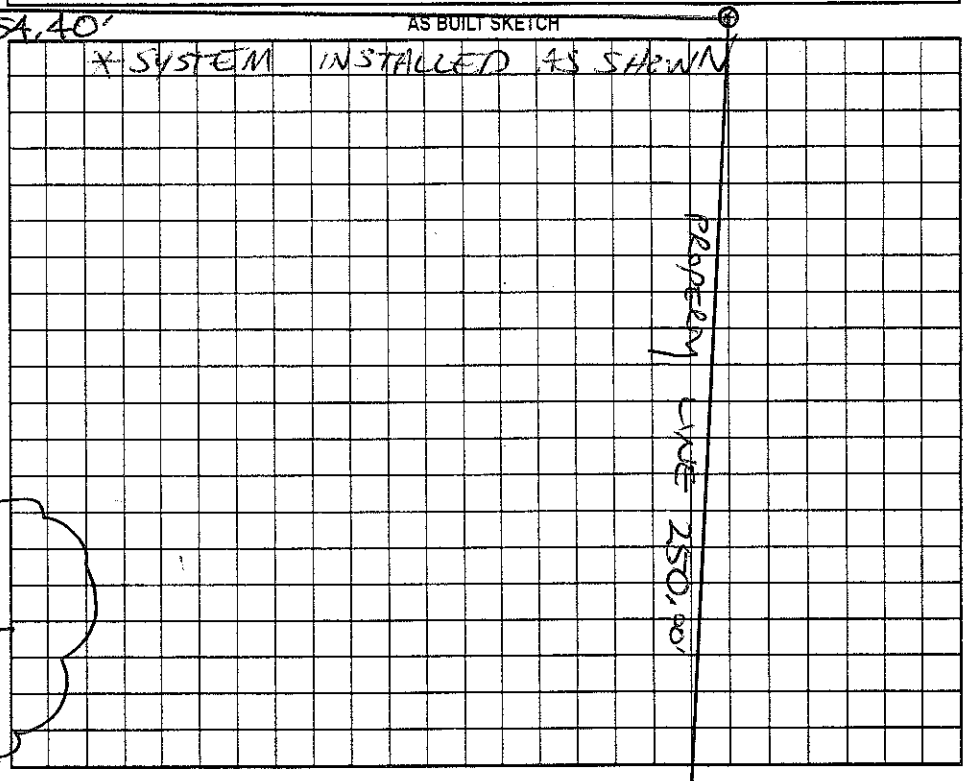

Permit can be suspended or revoked if any false information is supplied toward securing the permit/any unauthorized changes are made to the site/any unauthorized changes are made in the installation of the system. Improvement Permit with plat valid without expiration. Improvement Permit with site plan valid for sixty months. Authorization to Construct is valid for a period equal to that of Improvement Permit – not to exceed sixty months.

Signed: date 7-16-03 Installed by: ROWAN SEPTIC

Improvement Permit by: STEVE HEDRICK date 7-15-03 Operation Permit by: date 12-22-04

Authorization to Construct by: STEVE HEDRICK date 7-15-03 Existing System Inspection by: date

HEALTH DEPT. COPY: WHITE OWNER COPY (FINAL): YELLOW OWNER COPY (INITIAL): PINK