IREDELL COUNTY HEALTH DEPARTMENT

STATESVILLE 704-878-5305 MOORESVILLE 704-664-5281

IMPROVEMENT PERMIT / AUTHORIZATION TO CONSTRUCT / OPERATION PERMIT / EXISTING SYSTEM INSPECTION

PERMIT# 113914 PIN# ~~4728-03-2778~~ 4728-03-2871 DATE 7-15-03

OWNER OR CONTRACTOR CRANDALL & O'BRIEN CONSTRUCTION PHONE: Business 704-876-8600 Home

ADDRESS 310 TREEBARK LANE STATESVILLE NC 28625

LOCATION NC 115 NORTH TL PISGAH RD TL TREEBARK RD, TR HIDDEN RIVER LN, 2ND LOT ON RIGHT

SUBDIVISION HIDDEN RIVER BLOCK / SECTION LOT 2 LOT AREA 4.180 ACRES SITE CLASS. PS DESIGN FLOW 360 L.T.A.R. 0.30 GPD/FT²

Septic Tank: 1000 Gallons; STB 1007 Date 4-5-04
Pump Tank: Gallons; PT Date
Pump Make: Model Serial No.
Nitrification Field: No Fields 1 Square Feet 1200 Linear Feet 400
No Lines FOUR Trench Width 36" Max Trench Bottom Depth 36" Gravel Depth 12"

☑ New System ☐ Repair System Type: I, II, III, IV, V, VI
System Description: CONVENTIONAL GRAVITY
Repair System Description: CONV. GRAVITY
Maintenance Agreement Required: ☐ Yes ☑ No


☑ House/Mod. Home No. Bedrooms 3
☐ Mobile Home No. Bathrooms 2.5
☐ Business No. Employees
☐ Other
☐ Slab ☑ Crawl Space ☐ Basement w/plumbing ☐ Basement wo/plumbing

Water Supply: ☑ Individual ☐ Public ☐ Community WELL


Comments:/Conditions: ① INSTALL DRAINLINES ON CONTOUR AS FLAGGED ② KEEP SYSTEM MINIMUM 100 FEET FROM WELL

Comments:/Conditions: ① Tuff-tite filter ② 12" riser ③ #57 stone

INITIAL SITE SKETCH SCALE: 1"=100'

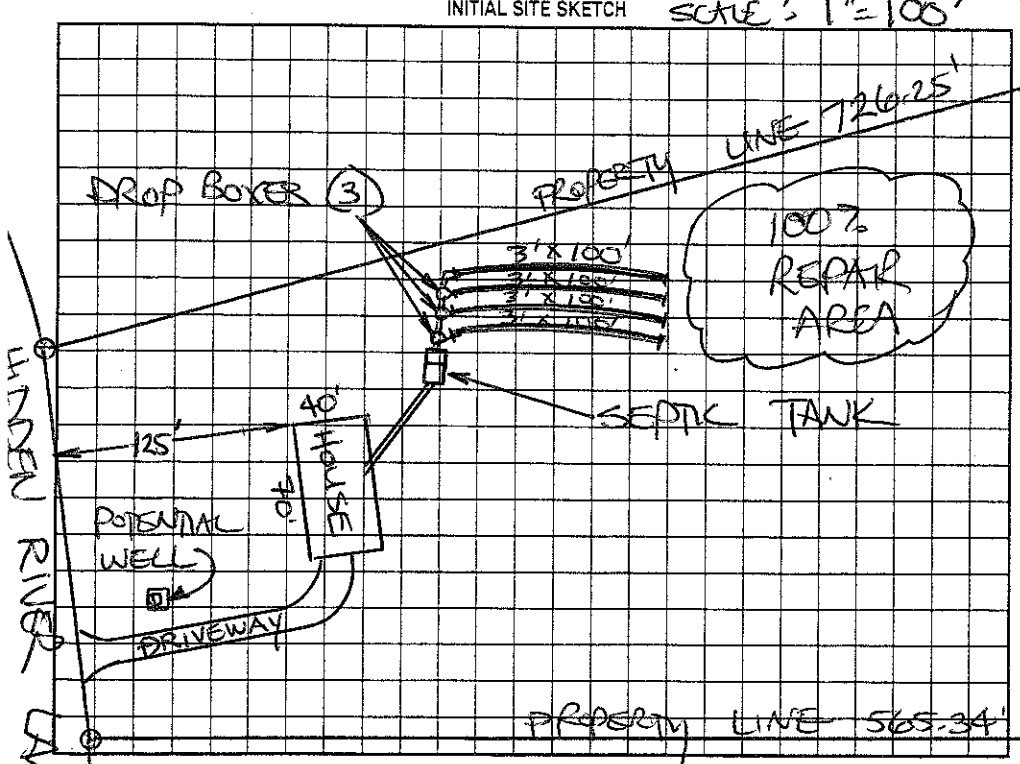

AS BUILT SKETCH

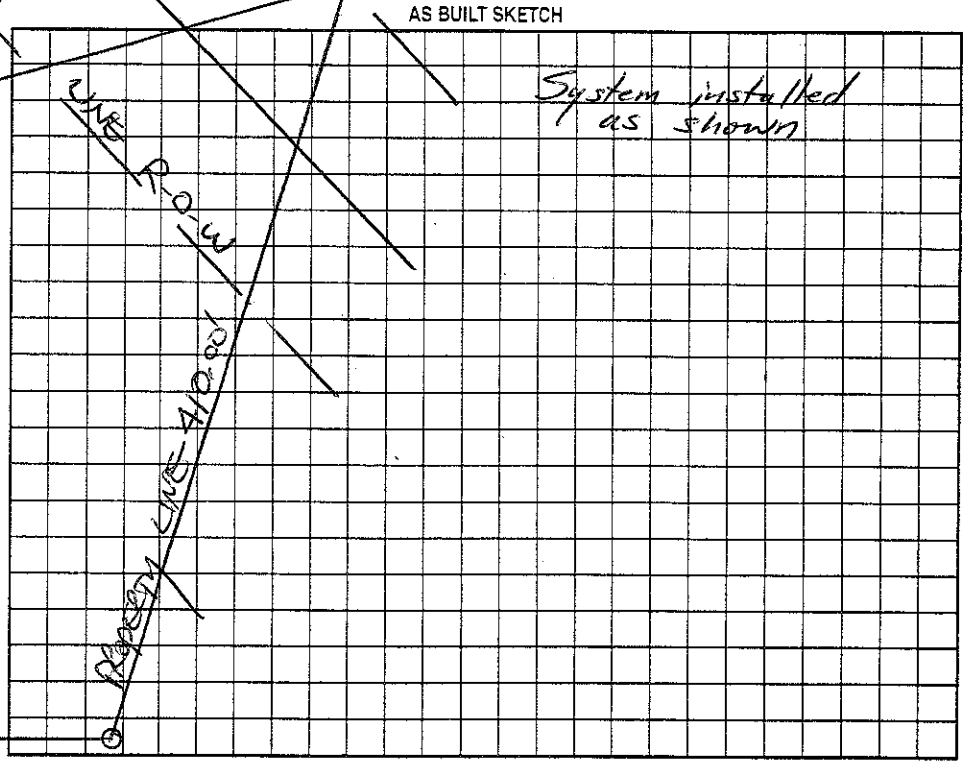

Permit can be suspended or revoked if any false information is supplied toward securing the permit/any unauthorized changes are made to the site/any unauthorized changes are made in the installation of the system. Improvement Permit with plat valid without expiration. Improvement Permit with site plan valid for sixty months. Authorization to Construct is valid for a period equal to that of Improvement Permit – not to exceed sixty months.

Signed: date 7-16-03 Installed by: Bill Greene

Improvement Permit by: STEVE HEDRICK date 7-15-03 Operation Permit by: Christopher A. Smith, RS date 6/8/04

Authorization to Construct by: STEVE HEDRICK date 7-15-03 Existing System Inspection by: date

HEALTH DEPT. COPY: WHITE OWNER COPY (FINAL): YELLOW OWNER COPY (INITIAL): PINK