IREDELL COUNTY HEALTH DEPARTMENT

STATESVILLE 704-878-5305 MOORESVILLE 704-664-5281

IMPROVEMENT PERMIT / AUTHORIZATION TO CONSTRUCT / OPERATION PERMIT / EXISTING SYSTEM INSPECTION

PERMIT# 27823 PIN# 4727-03-4039 DATE 6-20-05

OWNER OR CONTRACTOR EVA KIBLER PHONE: Business 704-902-7160 Home 704-276-6337

ADDRESS 158 GRASSY MEADOW LANE STATESVILLE, NC 28625

LOCATION 115 N @ PISGAH @ TOREADORE @ HIDDEN RIVER LOT # 17 ON LEFT

SUBDIVISION HIDDEN RIVER BLOCK / SECTION ____ LOT 17 LOT AREA 2.254 ac SITE CLASS. PS DESIGN FLOW 360 L.T.A.R. 13

Septic Tank: 1000 Gallons; STB 1012 Date 6-27-04
Pump Tank: ____ Gallons; PT ____ Date ____
Pump Make: ____ Model ____ Serial No. ____
Nitrification Field No. Fields 1 Square Feet 1200' Linear Feet ~~300'~~ 400'
No. Lines ~~3~~ 4 Trench Width 36" Max Trench Bottom Depth 36" Gravel Depth 12"

☒ New System ☐ Repair System Type: I, II, III, IV, V, VI
System Description: ~~Conv~~ 25% Grav
Repair System Description: PUMP CONV
Maintenance Agreement Required: ☐ Yes ☐ No


☒ House/Mod. Home No. Bedrooms 3
☐ Mobile Home No. Bathrooms 2½
☐ Business No. Employees ____
☐ Other ____
☐ Slab ☐ Crawl Space ☐ Basement w/plumbing ☐ Basement wo/plumbing

Water Supply: ☒ Individual ☐ Public ☐ Community


Comments:/Conditions: ONO PERMITS ISSUED AT TIME OF L/O ON ADJACENT LOTS @ INSTALL LINES ON CONTOURS & MAINTAIN SETBACKS

Comments:/Conditions: "AN ALTERED SYSTEM MAY ALSO BE USED"
Yellow Tuff Tite – 75 Quick 4 Chambers
Septic Safety Wood installed

INITIAL SITE SKETCH 1"=50'

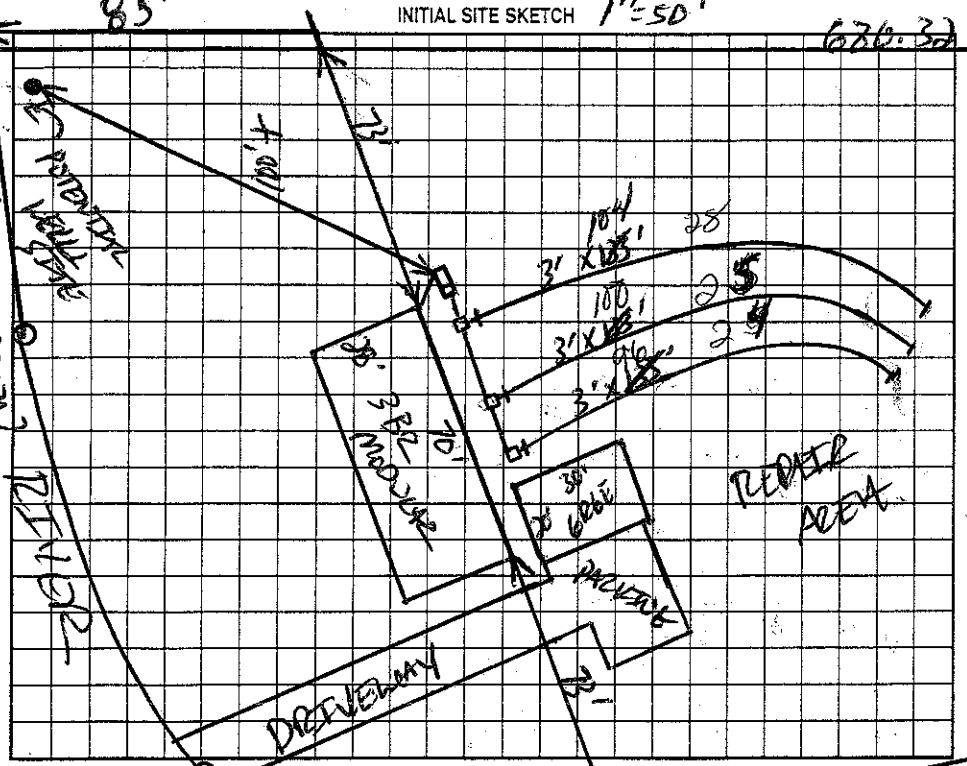

AS-BUILT SKETCH

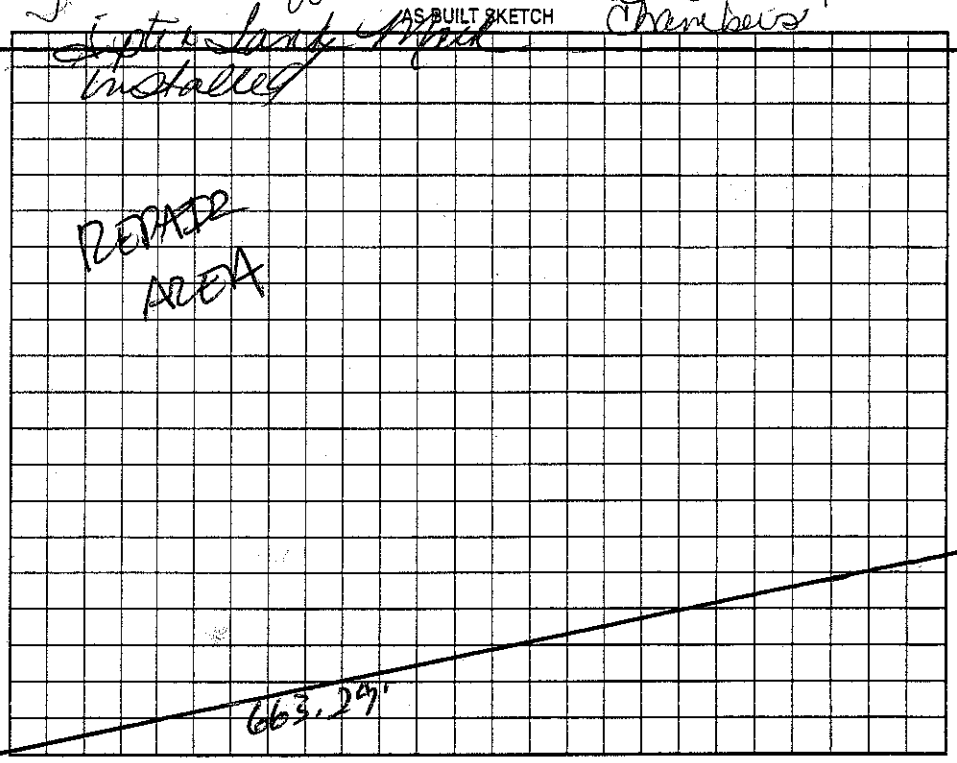

Permit can be suspended or revoked if any false information is supplied toward securing the permit/any unauthorized changes are made to the site/any unauthorized changes are made in the installation of the system. Improvement Permit with plat valid without expiration. Improvement Permit with site plan valid for sixty months. Authorization to Construct is valid for a period equal to that of Improvement Permit – not to exceed sixty months.

Signed: Kenneth Kiser date 6-21-05 Installed by: Hi backhoe

Improvement Permit by: [signature] date 6-20-05 Operation Permit by: Kenneth Cook date 6-30-05

Authorization to Construct by: [signature] date 6-20-05 Existing System Inspection by: ____ date ____

HEALTH DEPT. COPY: WHITE OWNER COPY (FINAL): YELLOW OWNER COPY (INITIAL): PINK