IREDELL COUNTY HEALTH DEPARTMENT

STATESVILLE 704-878-5305 MOORESVILLE 704-664-5281

IMPROVEMENT PERMIT / AUTHORIZATION TO CONSTRUCT / OPERATION PERMIT / EXISTING SYSTEM INSPECTION

PERMIT# 127823 PIN# 4727-03-4039 DATE 6-30-05

OWNER OR CONTRACTOR EVA KIBLER PHONE: Business 704-902-7160 Home 704-276-6327

ADDRESS 158 GRASSY MEADOW LANE STATESVILLE, NC 28625

LOCATION 115 N ⓛ PISGAH ⓛ TOLERSAVE @ HIDDEN RIVER LOT # 17 ON LEFT

SUBDIVISION HIDDEN RIVER BLOCK / SECTION ____ LOT 17 LOT AREA 2.284 ac SITE CLASS. IS DESIGN FLOW 360 L.T.A.R. 13

Septic Tank: 1000 Gallons; STB 1012 Date 10-27-04

Pump Tank: ____ Gallons; PT ____ Date ____

Pump Make: ____ Model ____ Serial No. ____

Nitrification Field(s) No. Fields 1 Square Feet 1200' Linear Feet ~~400'~~ 300'

No Lines ~~5~~ 3 Trench Width 36" Max Trench Bottom Depth 36" Gravel Depth 0"

☒ New System ☐ Repair System Type: I, II, III, IV, V, VI

System Description: ~~Conv~~ 25% Grav

Repair System Description: Pump Conv

Maintenance Agreement Required: ☐ Yes ☐ No

☒ House/Mod. Home No. Bedrooms 3

☐ Mobile Home No. Bathrooms 2½

☐ Business No. Employees ____

☐ Other ____

☐ Slab ☐ Crawl Space ☐ Basement w/plumbing ☐ Basement wo/plumbing


Water Supply: ☒ Individual ☐ Public ☐ Community

Comments:/Conditions: ①NO PERMITS ISSUED AT TIME OF L/O ON ADJACENT LOTS ② INSTALL CURB ON CONTOURS & MAINTAIN SETBACKS


Comments:/Conditions: "AN ALLOTED SYSTEM MAY ALSO BE USED"

Yellow Tuff Tite – 75 Quick 4 Chambers

INITIAL SITE SKETCH 1"=50'

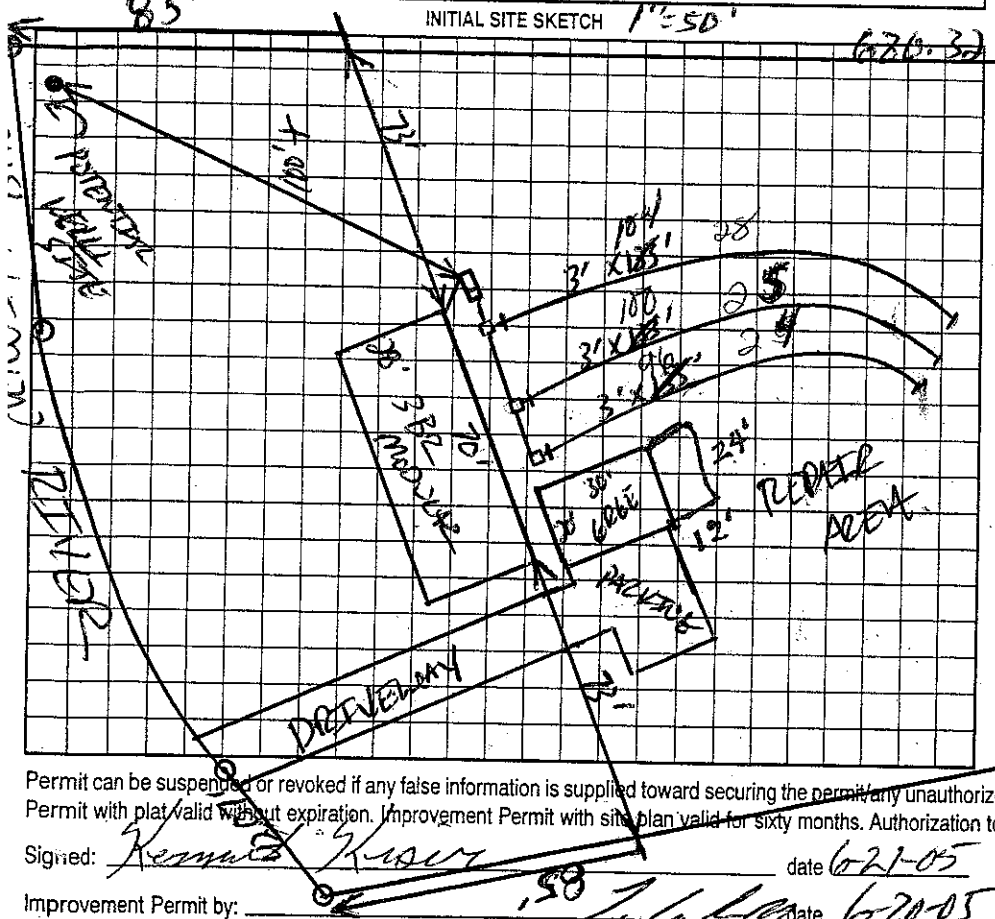

AS-BUILT SKETCH

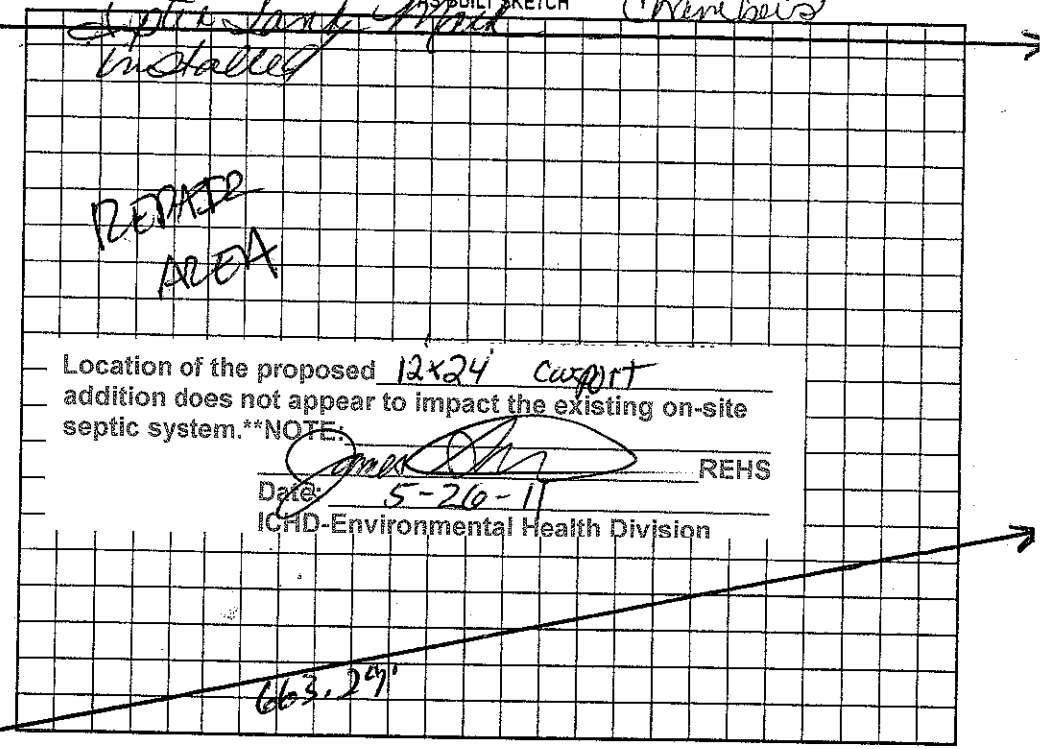

Location of the proposed 12x24' carport addition does not appear to impact the existing on-site septic system.**NOTE:

REHS

Date: 5-26-11

ICHD-Environmental Health Division

Permit can be suspended or revoked if any false information is supplied toward securing the permit/any unauthorized changes are made to the site/any unauthorized changes are made in the installation of the system. Improvement Permit with plat valid without expiration. Improvement Permit with site plan valid for sixty months. Authorization to Construct is valid for a period equal to that of Improvement Permit – not to exceed sixty months.

Signed: Kenneth Kiser date 6-21-05 Installed by: H-I Backhoe

Improvement Permit by: ____ date 6-20-05 Operation Permit by: Kelly Cook date 6-30-05

Authorization to Construct by: ____ date 6-20-05 Existing System Inspection by: ____ date ____

HEALTH DEPT. COPY: WHITE OWNER COPY (FINAL): YELLOW OWNER COPY (INITIAL): PINK