IREDELL COUNTY HEALTH DEPARTMENT

STATESVILLE 704-878-5305 (C1) MOORESVILLE 704-664-5281

IMPROVEMENT PERMIT / AUTHORIZATION TO CONSTRUCT / OPERATION PERMIT / EXISTING SYSTEM INSPECTION

PERMIT# 17733 PIN# 4728-04-4645 DATE 1-21-04

OWNER OR CONTRACTOR SPEAR CONSTRUCTION PHONE: Business 704-636-7954 Home 704-902-4642

ADDRESS 607 ANDERSON AVE, SALISBURY, NC 28144

LOCATION NC 115 N. TL DISCAH ROAD, TL TREEBARK ROAD, 0.2 MILE ON RIGHT

SUBDIVISION TREEBARK ACRES BLOCK / SECTION III LOT 8 LOT AREA 3.47 ACRES SITE CLASS. PS DESIGN FLOW 360 L.T.A.R. 0.30 GPD/FT²

Septic Tank: 1000 Gallons; STB 825 Date 1-25-04
Pump Tank: ____ Gallons; PT ____ Date ____
Pump Make: ____ Model ____ Serial No. ____
Nitrification Field: No Fields 1 Square Feet 1200 Linear Feet 400
No Lines FIVE Trench Width 36" Max Trench Bottom Depth 36" Gravel Depth 12"

☑ New System ☐ Repair System Type: I, II, III, IV, V, VI
System Description: CONVENTIONAL; GRAVITY
Repair System Description: CONVENTIONAL; GRAVITY
Maintenance Agreement Required: ☐ Yes ☑ No

☑ House/Mod. Home No. Bedrooms 3
☐ Mobile Home No. Bathrooms 2
☐ Business No. Employees ____
☐ Other ____


☐ Slab ☑ Crawl Space ☐ Basement w/plumbing ☐ Basement wo/plumbing

Water Supply: ☑ Individual ☐ Public ☐ Community


Comments:/Conditions: ① INSTALL LINES ON CONTOUR AS SHOWN ② KEEP SYSTEM MINIMUM 100 FEET FROM WELL

Comments:/Conditions: ① SEPTIC TANK RELOCATED AS SHOWN WITHOUT PRIOR HEALTH DEPARTMENT APPROVAL. KEEP DECK MINIMUM 5' FROM SYSTEM ② SEPTIC TANK WITH MARKER INSTALLED USING "POLYLOK" FILTER

INITIAL SITE SKETCH

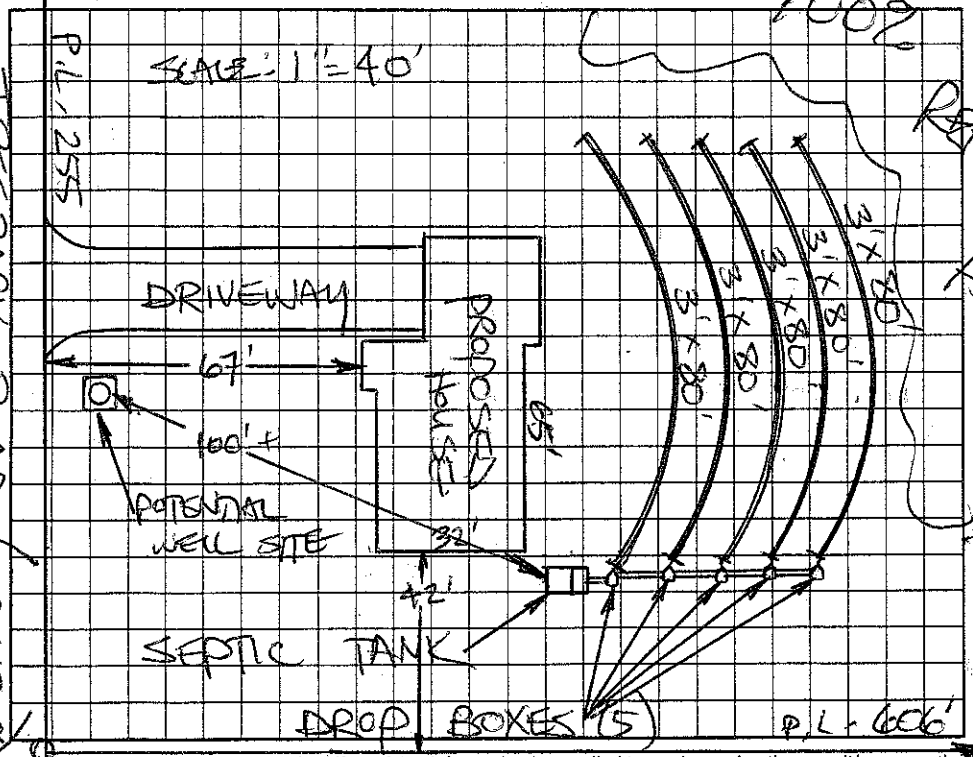

AS BUILT SKETCH

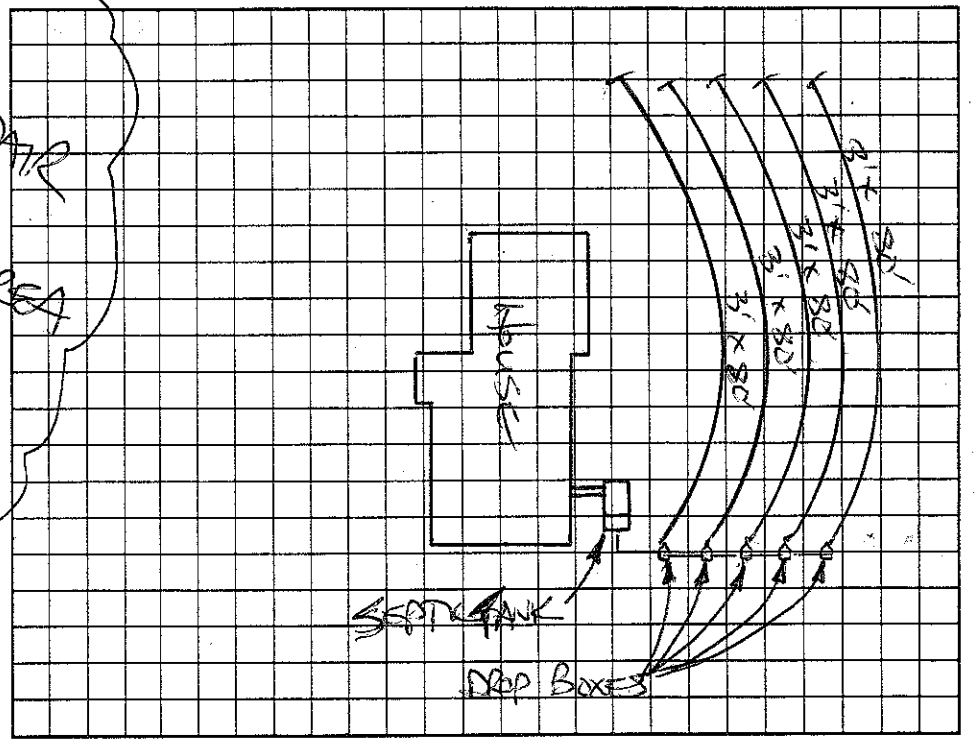

Permit can be suspended or revoked if any false information is supplied toward securing the permit/any unauthorized changes are made to the site/any unauthorized changes are made in the installation of the system. Improvement Permit with plat valid without expiration/Improvement Permit with site plan valid for sixty months. Authorization to Construct is valid for a period equal to that of Improvement Permit – not to exceed sixty months.

Signed: [signature] date 1-21-04 Installed by: ROWAN SEPTIC

Improvement Permit by: STEVE HEDRICK date 1-21-04 Operation Permit by: STEVE HEDRICK date 4-2-04

Authorization to Construct by: STEVE HEDRICK date 1-21-04 Existing System Inspection by: ____ date ____

HEALTH DEPT. COPY: WHITE OWNER COPY (FINAL): YELLOW OWNER COPY (INITIAL): PINK