IREDELL COUNTY HEALTH DEPARTMENT

STATESVILLE 704-878-5305 MOORESVILLE 704-664-5281

IMPROVEMENT PERMIT / AUTHORIZATION TO CONSTRUCT / OPERATION PERMIT / EXISTING SYSTEM INSPECTION

PERMIT# 118707 PIN# 4728-05-1804 DATE 3-5-04

OWNER OR CONTRACTOR TIMOTHY ECKLIFF PHONE: Business Home 704-876-4878

ADDRESS 1037 OLIN LOOP RD OLIN NC 28660

LOCATION 115 N @ PISGAH ON @ AFTER TREEBARK RD.

SUBDIVISION TREEBARK ACRES BLOCK / SECTION 2 LOT #1 LOT AREA 1.3 SITE CLASS PS DESIGN FLOW 480 L.T.A.R. .25 GPD/FT²

Septic Tank: 1000 Gallons; STB 1012 Date 9-30-03
Pump Tank: Gallons; PT Date
Pump Make: Model Serial No.
Nitrification Field: No Fields 1 Square Feet EQ 1920 Linear Feet 640
No Lines 4 Trench Width 36" Max Trench Bottom Depth 24" Gravel Depth 12"

☑ New System ☐ Repair System Type: I (II) III, IV, V, VI
System Description: CONVENTIONAL GRAVITY
Repair System Description: GRAVITY 25% RED.
Maintenance Agreement Required: ☐ Yes ☑ No


☑ House/Mod. Home No. Bedrooms 4
☐ Mobile Home No. Bathrooms 3
☐ Business No. Employees
☐ Other
☐ Slab ☑ Crawl Space ☐ Basement w/plumbing ☐ Basement wo/plumbing

Water Supply: ☑ Individual ☐ Public ☐ Community WELL

Comments:/Conditions: (1) MAINTAIN ALL SETBACKS (2) INSTALL LINES 20-24" ON CONTOUR (3) INSTALL SUBSURFACE INTERCEPTOR DRAIN @ 36" MAINTAINING 12" SEPARATION VERTICALLY (4) MUST REMOVE BERMS PRIOR TO INSTALLATION

Comments:/Conditions: (1) TUFF TITE FILTER (2) #5 STONE (3) FRENCH DRAIN INSTALLED AT 48" W/ AT 1"/100'

INITIAL SITE SKETCH SCALE 1"=60'

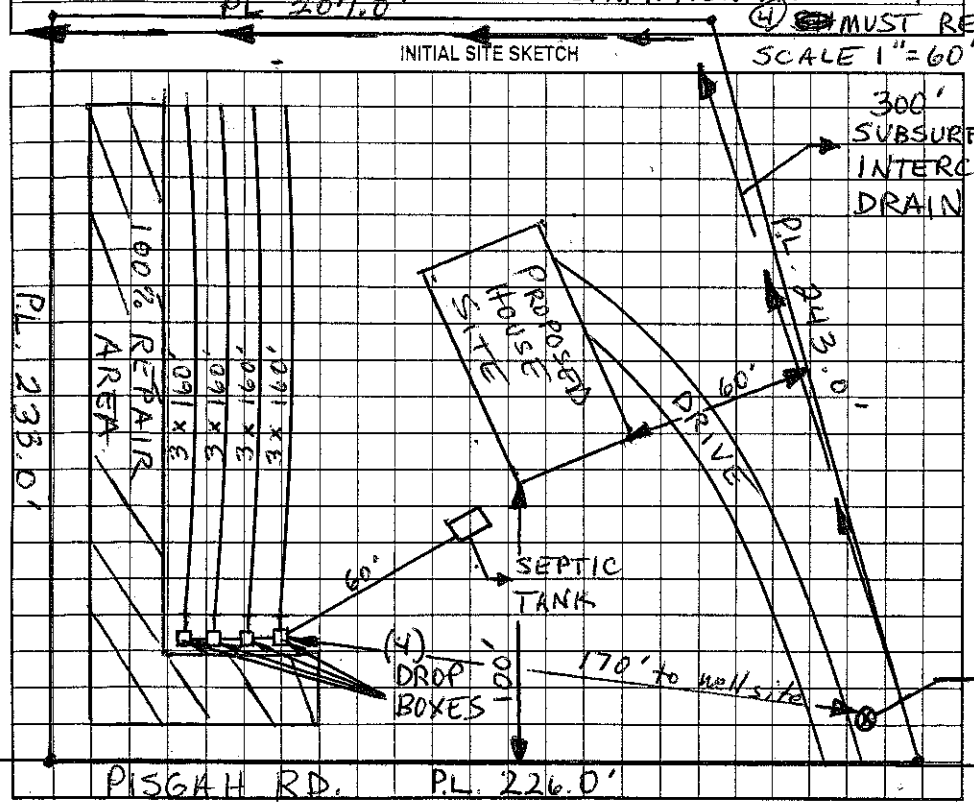

AS BUILT SKETCH

* System installed according to sketch

Permit can be suspended or revoked if any false information is supplied toward securing the permit/any unauthorized changes are made to the site/any unauthorized changes are made in the installation of the system. Improvement Permit with plat valid without expiration. Improvement Permit with site plan valid for sixty months. Authorization to Construct is valid for a period equal to that of Improvement Permit – not to exceed sixty months.

Signed: Timothy A Eckliff date

Improvement Permit by: Christopher M. Shemwell, RS date 3-5-04

Authorization to Construct by: Christopher M. Shemwell, RS date 3-5-04

Installed by: C+S GRADING

Operation Permit by: Christopher M. Shemwell, RS date 8-12-04

Existing System Inspection by: date

HEALTH DEPT. COPY: WHITE OWNER COPY (FINAL): YELLOW OWNER COPY (INITIAL): PINK