IREDELL COUNTY HEALTH DEPARTMENT

THIS PERMIT VOIDS PREVIOUS ISSUED 11-15-2004

STATESVILLE 704-878-5305 (C1) MOORESVILLE 704-664-5281

IMPROVEMENT PERMIT / AUTHORIZATION TO CONSTRUCT / OPERATION PERMIT / EXISTING SYSTEM INSPECTION

PERMIT# 124291 PIN# 4728-05-2626 DATE 9-17-05

OWNER OR CONTRACTOR TERI CROSIER PHONE: Business 704-224-4229 Home 704-872-3388

ADDRESS 2030 SIMONTON ROAD STATESVILLE NC 28625

LOCATION NC 115 NORTH, TL PISGAH CHURCH ROAD TL TREEBARK ROAD, 2ND LOT ON RIGHT

SUBDIVISION TREEBARK ACRES BLOCK / SECTION II LOT 3 LOT AREA 1.19 ACRES SITE CLASS PS DESIGN FLOW 480 L.T.A.R. 0.25 GPD/FT²

Septic Tank: 1000 Gallons; STB $25 Date 10-21-04
Pump Tank: 1000 Gallons; PT 302 Date
Pump Make: GOULD Model ME1012H Serial No. A0544779
Nitrification Field: No Fields 1 Square Feet Eq. 1920 Linear Feet 480
No Lines SIX Trench Width 36" Max Trench Bottom Depth 36" Gravel Depth N/A

☑ New System ☐ Repair System Type: I, II, (III), IV, V, VI
System Description: 25% REDUCTION PUMP
Repair System Description: 50% REDUCTION, LOW-PRESSURE
Maintenance Agreement Required: ☐ Yes ☑ No ☐ Other

☑ House/Mod. Home No. Bedrooms 4
☐ Mobile Home No. Bathrooms
☐ Business No. Employees
☐ Slab ☐ Crawl Space ☑ Basement w/plumbing ☐ Basement wo/plumbing


Water Supply: ☑ Individual ☐ Public ☐ Community WELL

Comments:/Conditions: ① ABANDON EXISTING UNAPPROVED DRAINLINES ② INSTALL NEW DRAINLINES AS FLAGGED ON CONTOUR, NO DEEPER THAN 36", 3' WIDE TRENCHES, USING NEW 25% REDUCTION SYSTEM.

INITIAL SITE SKETCH

Comments:/Conditions: ③ SEE ATTACHED SHEETS FOR PUMP & PRESSURE MANIFOLD REQUIREMENTS. SEPTIC TANK W/ MARKER & THETIS FILTER INSTALLED

AS BUILT SKETCH

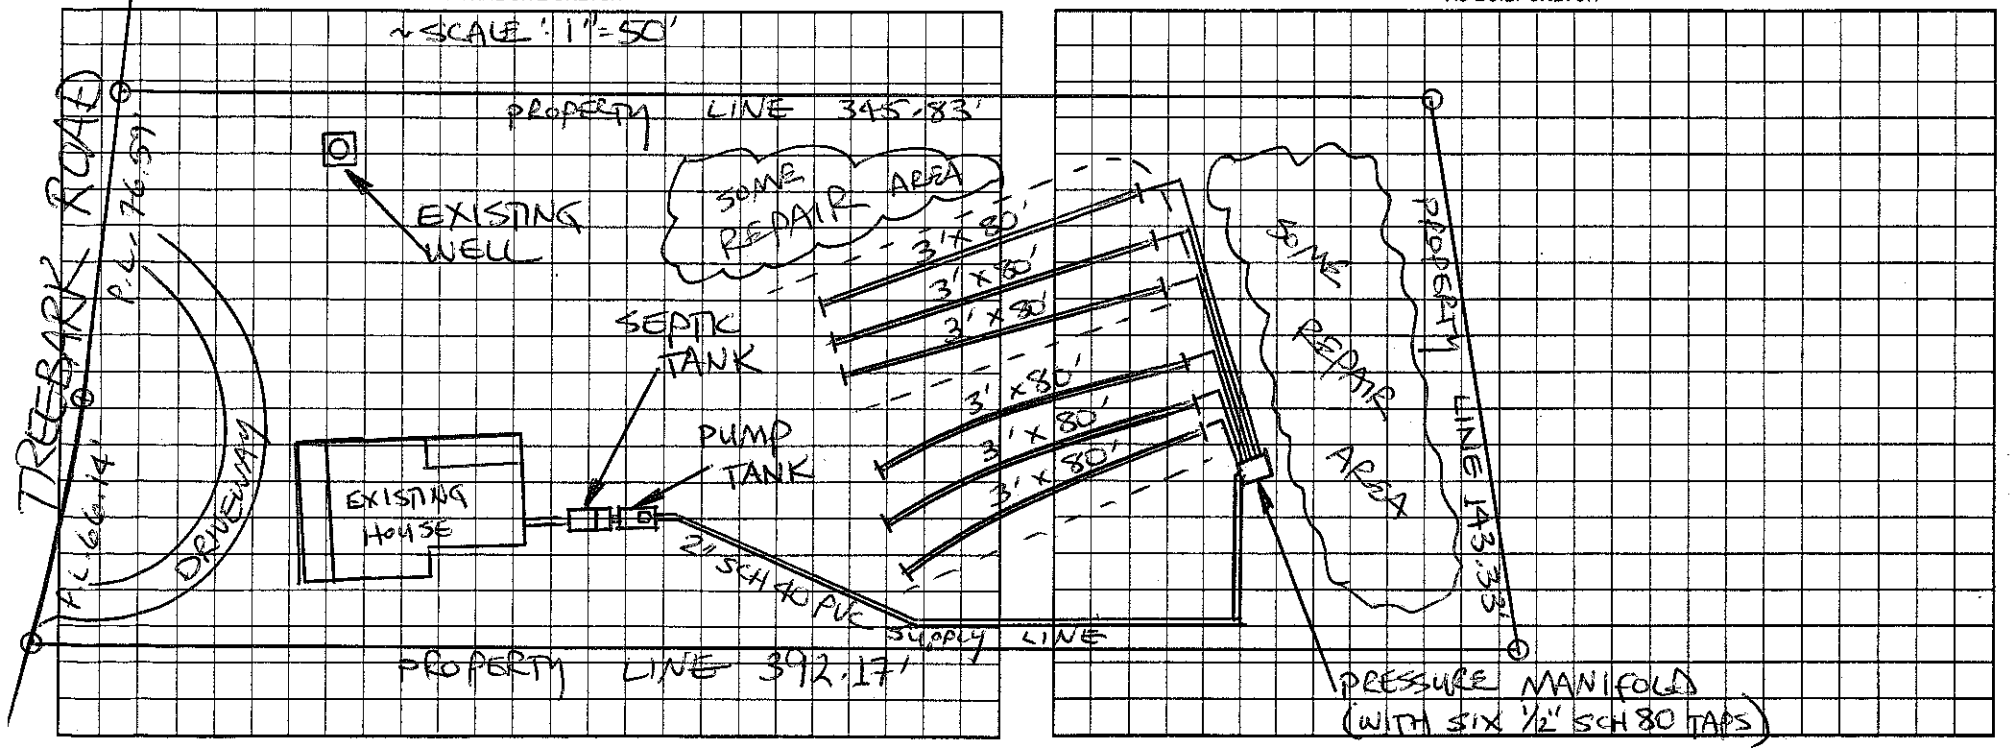

Permit can be suspended or revoked if any false information is supplied toward securing the permit/any unauthorized changes are made to the site/any unauthorized changes are made in the installation of the system. Improvement Permit with plat valid without expiration. Improvement Permit with site plan valid for sixty months. Authorization to Construct is valid for a period equal to that of Improvement Permit – not to exceed sixty months.

Signed Teri Crosier date 9/19/05 Installed by: ESKER ELDER

Improvement Permit by: STEVE HEDRICK date 9-17-05 Operation Permit by: STEVE HEDRICK date 10-5-07

Authorization to Construct by: STEVE HEDRICK date 9-17-05 Existing System Inspection by: date

HEALTH DEPT. COPY: WHITE OWNER COPY (FINAL): YELLOW OWNER COPY (INITIAL): PINK