IREDELL COUNTY HEALTH DEPARTMENT

STATESVILLE 704-878-5305 MOORESVILLE 704-664-5281

IMPROVEMENT PERMIT / AUTHORIZATION TO CONSTRUCT / OPERATION PERMIT / EXISTING SYSTEM INSPECTION

PERMIT# 129402 PIN# 4728053222 16 DATE 10-31-05

OWNER OR CONTRACTOR Charles Scott PHONE: Business 704-8808533 Home 704-8719559

ADDRESS 514 Walnut St Statesville NC 28677

LOCATION 115 W Mizpah Church Rd To Treebark 1st lot on Rt Past Lazy lane

SUBDIVISION Treebark Acres BLOCK / SECTION II LOT 15 LOT AREA SITE CLASS. DESIGN FLOW L.T.A.R. .3

Septic Tank: 1000 Gallons; STB WP1007 Date 4-13-05
Pump Tank: 1000 Gallons; PT WP274 Date 4-15-05
Pump Make: Model Serial No.
Nitrification Field: No Fields Square Feet 1200 Linear Feet 300
No Lines 4 Trench Width 36 Max Trench Bottom Depth 36" Gravel Depth NA

☐ New System ☐ Repair System Type: I, II, III, IV, V, VI
System Description 25% Red - Pump
Repair System Description: 25% Red Pump
Maintenance Agreement Required: ☐ Yes ☑ No
☐ Slab ☐ Crawl Space ☐ Basement w/plumbing ☐ Basement wo/plumbing


☑ House/Mod. Home No. Bedrooms 3
☐ Mobile Home No. Bathrooms
☐ Business No. Employees
☐ Other

Water Supply:
☑ Individual
☐ Public
☐ Community

Comments:/Conditions: Install on Contour maintain all setbacks

Comments:/Conditions: Tank Riser installed grey water filter installed tank Riser on pump tank

INITIAL SITE SKETCH

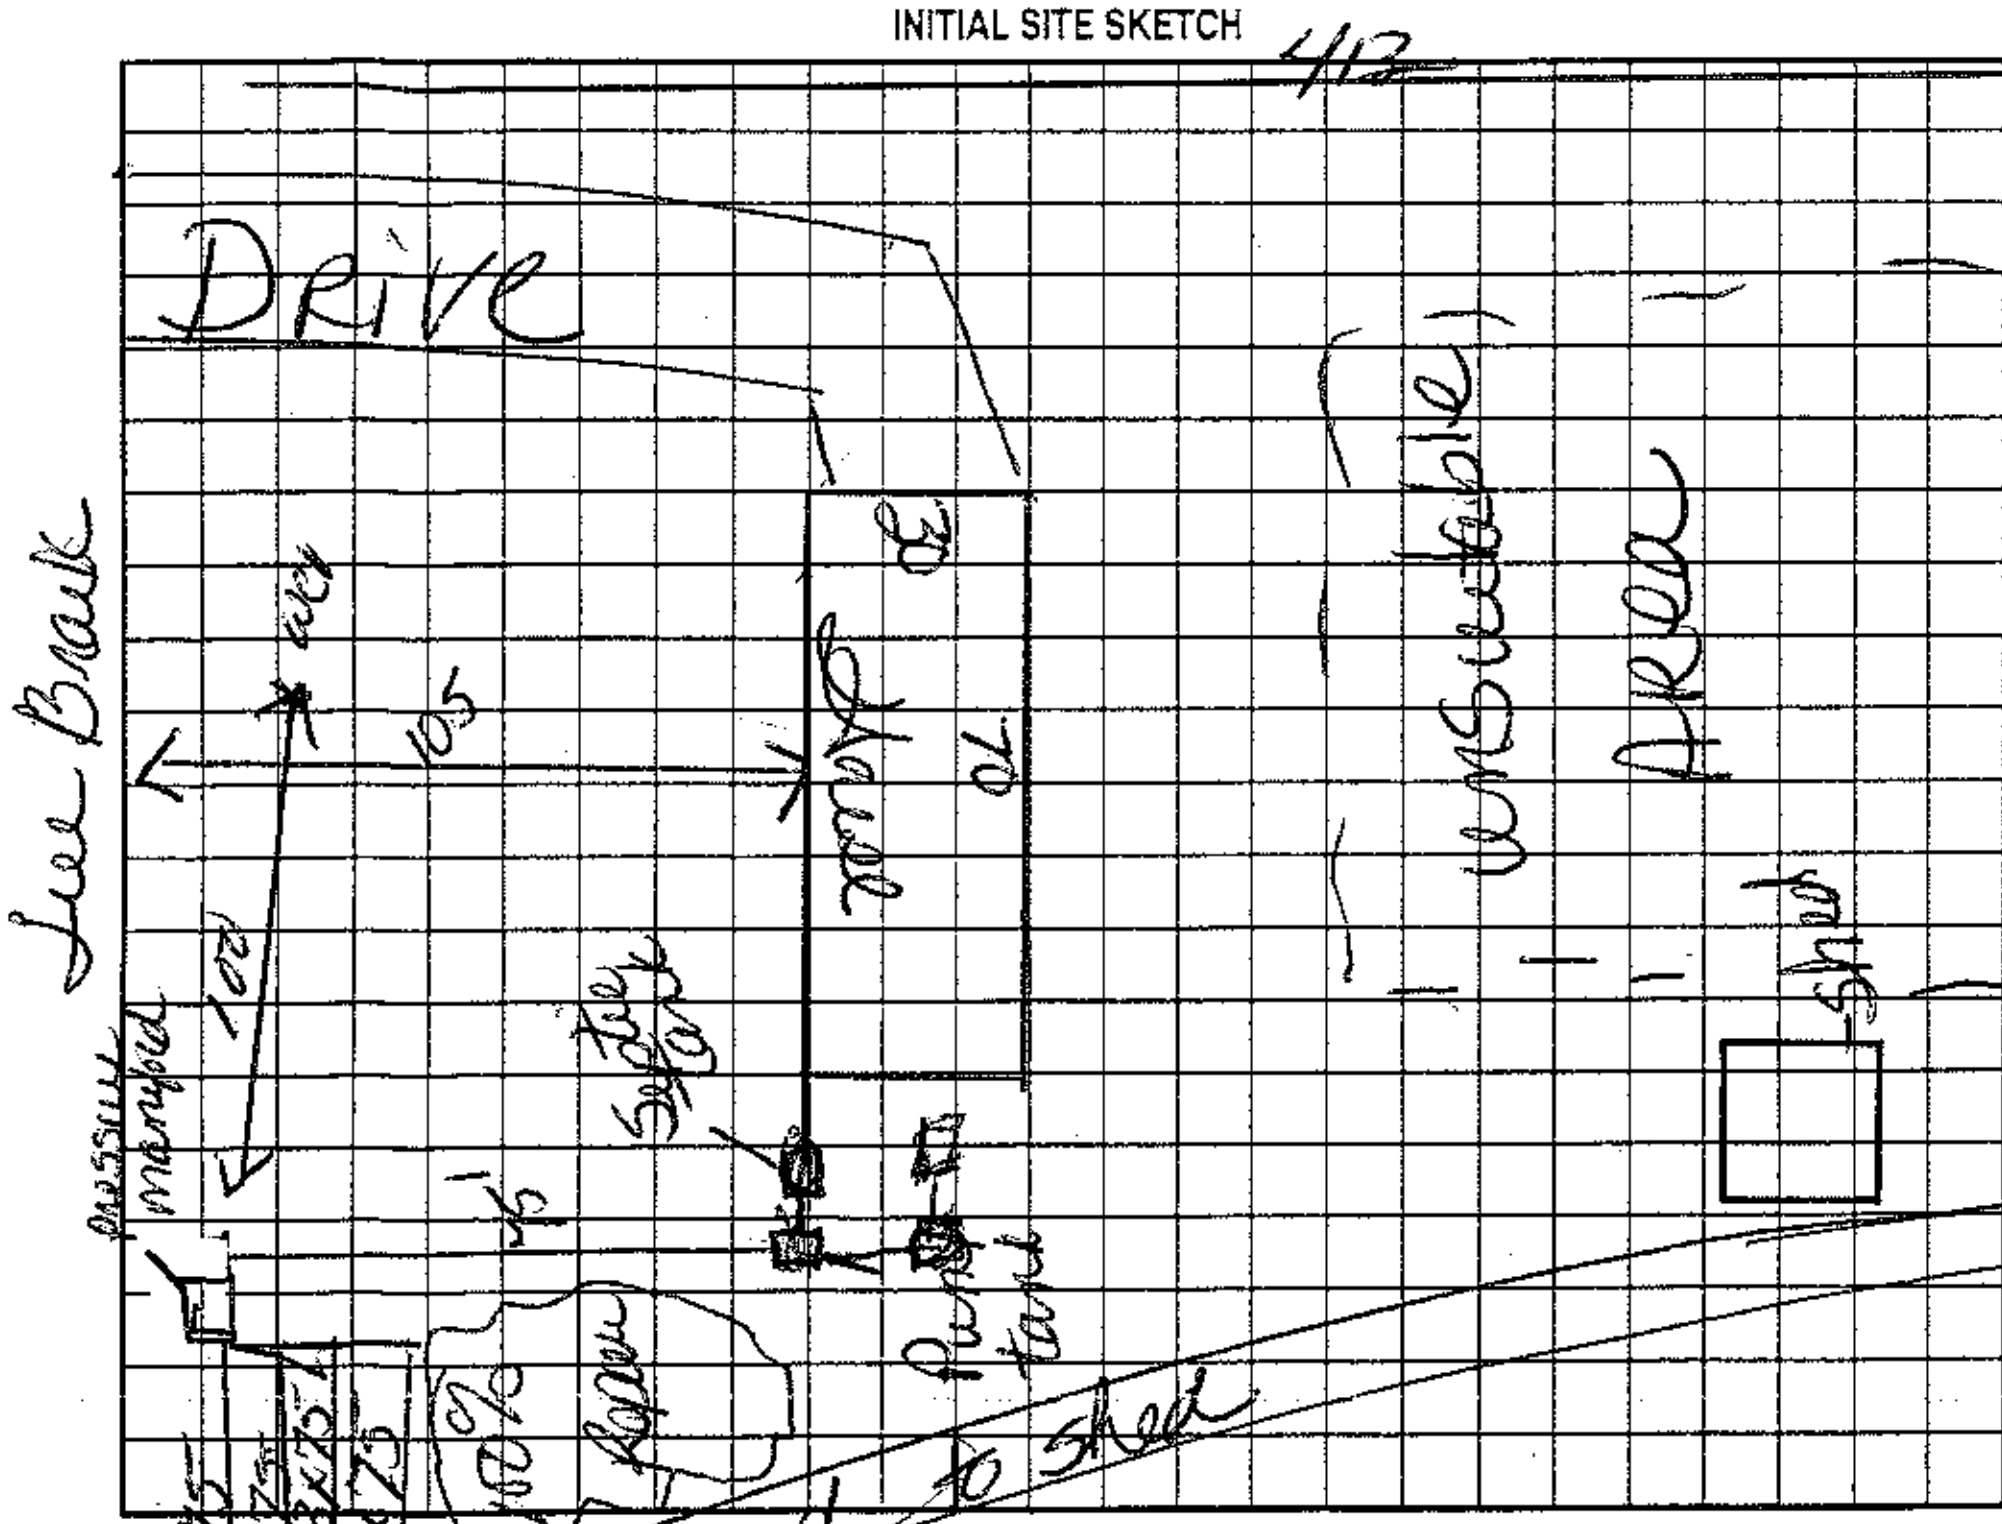

AS BUILT SKETCH

N 152-A
4 hp/c CSAus
152-002
Checked system layout on 11-10-05 Kelly J Cook
Checked Pres head 10-14-05 Kelly J Cook

Permit can be suspended or revoked if any false information is supplied toward securing the permit/any unauthorized changes are made to the site/any unauthorized changes are made in the installation of the system. Improvement Permit with plat valid without expiration. Improvement Permit with site plan valid for sixty months. Authorization to Construct is valid for a period equal to that of Improvement Permit – not to exceed sixty months.

Signed: [signature] date 11/11/05 Installed by: Rowan Septic

Improvement Permit by: Kelly J Cook date 10-31-05 Operation Permit by: Kelly J Cook date 10-14-05

Authorization to Construct by: Kelly J Cook date 10-31-05 Existing System Inspection by: date

HEALTH DEPT. COPY: WHITE OWNER COPY (FINAL): YELLOW OWNER COPY (INITIAL): PINK