IREDELL COUNTY HEALTH DEPARTMENT

STATESVILLE 704-878-5305 MOORESVILLE 704-664-5281

IMPROVEMENT PERMIT / AUTHORIZATION TO CONSTRUCT / OPERATION PERMIT / EXISTING SYSTEM INSPECTION

PERMIT # 158736 PIN # 4728-05-5479 DATE 3 November 09

OWNER or APPLICANT Richard Bullcrap PHONE: Business (704) 876-0665 Home:

OWNER or APPLICANT ADDRESS 126 Treebark Rd. Statesville

LOCATION / DIRECTIONS 115 N TL Pisgah Ch. Rd. TL Treebark Rd. 4th lot on Lft.

SUBDIVISION Treebark BLOCK / SECTION LOT # 12 LOT AREA 0.59ac. DESIGN FLOW 360 g/d L.T.A.R. 0.3 /Ft

Septic Tank 1000g Gallons: STB 1012-10w Date 5-10-09
Pump Tank Gallons: P T Date
Pump Make Model Serial #
Nitrification Field No Fields 1 No Lines 3 Linear Feet 300'
Trench Width 36" Max. Trench Bottom Depth 36" Gravel Depth NA

☑ New System ☐ Repair ☐ Expansion System Type I II (III) IV V VI
System Description: 25% Reduction
Repair System Description: 25% Reduction
Maintenance Agreement Required ☐ YES ☑ NO
☑ GRAVITY ☐ PRESSURE


☑ Residence No. Bedrooms 3
☐ Business No. Persons
☐ Other No. Employees
☑ Slab ☐ Crawl Space
☐ Basement w/plumbing ☐ Basement w/o plumbing

Water Supply: ☑ Private ☐ Public ☐ Community


Comments / Conditions: Follow Contour/

Comments / Conditions: Polylok Filter.

INITIAL SITE SKETCH

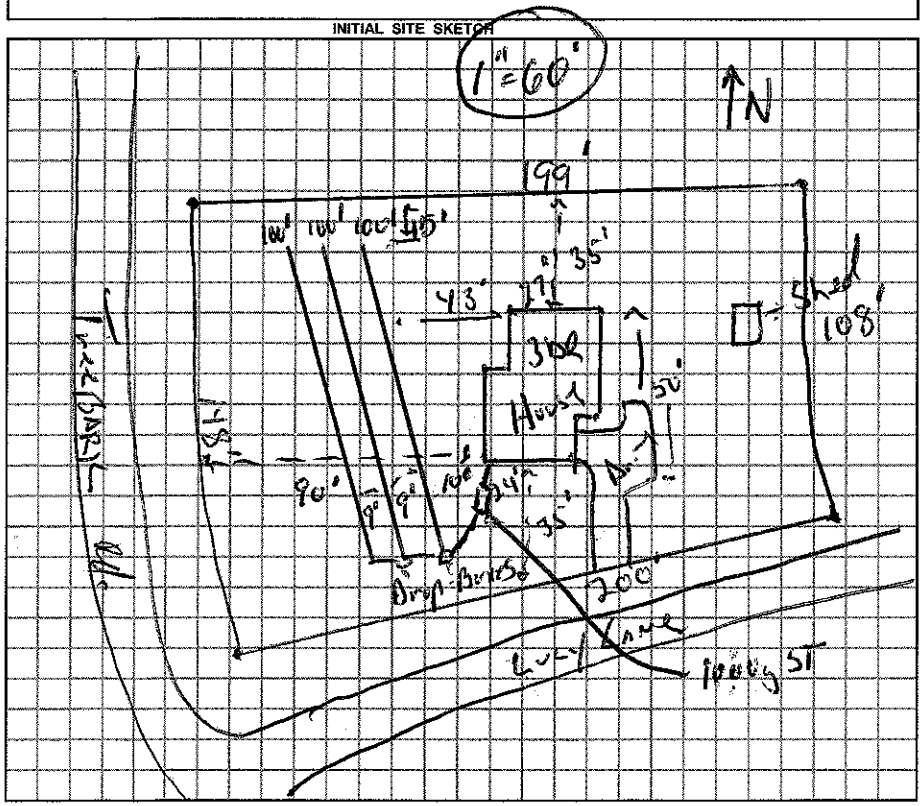

AS BUILT SKETCH

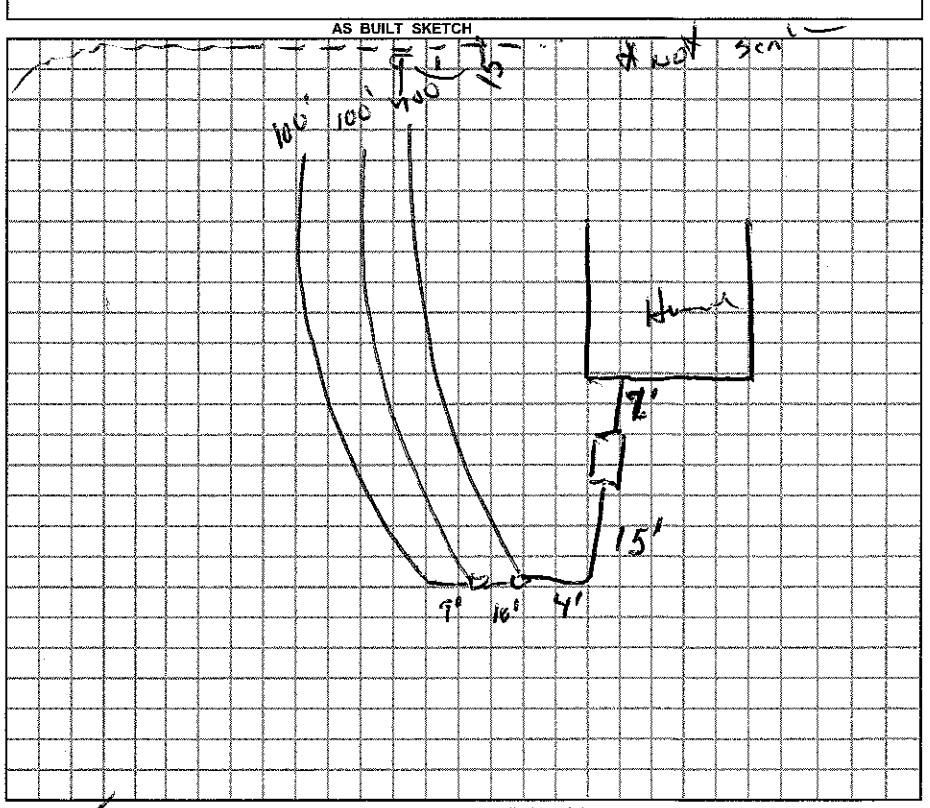

Permit can be suspended or revoked if any false information is supplied toward securing the permit / any unauthorized changes are made to the site / any unauthorized changes are made in the installation of the system.

☐ *IMPROVEMENT PERMIT w / plat valid without expiration.* ☑ *IMPROVEMENT PERMIT w / site plan valid for 60 mos.* ☑ *AUTHORIZATION TO CONSTRUCT valid for period equal to IMPROVEMENT PERMIT-not to exceed 60 mo.*

Owner / Applicant Signature: Date 11-4-09

Improvement Permit by: R.S. Date 3 Nov. 09

Authorization to Construct by: R.S. Date 3 Nov. 09

Installed by: Gradin

Operation Permit by: R.S. Date: 4 November 09

Existing System Inspected by: Date:

YOU SHOULD CONTACT A LOCATOR SERVICE PRIOR TO ANY EXCAVATION.

WHITE COPY Environmental Health YELLOW COPY (Final) Owner / Applicant PINK COPY (Initial) Owner / Applicant