#62778

IREDELL COUNTY HEALTH DEPARTMENT

STATESVILLE 704-878-5305 MOORESVILLE 704-664-5281

IMPROVEMENT PERMIT / CERTIFICATE OF COMPLETION / OPERATION PERMIT / EXISTING SYSTEM INSPECTION

PROPERTY DESCRIPTION NO. 24199 DATE 7-20-96 TAX MAP NO. 143- 1- A- 11 Watershed ☐ Yes ☑ No

OWNER OR CONTRACTOR RANDALL LEE HARTLINE PHONE: Business Home 872-2385

ADDRESS 863 BARRY OAK ROAD, CLEVELAND, NC 27013

LOCATION NC 115 N, TL PISGAH ROAD, TL TREEBARK ROAD, 3RD LOT ON LEFT

SUBDIVISION TREEBARK ACRES BLOCK / SECTION LOT 11 LOT AREA 145'X200'X112'X200' SITE CLASS. IPS DESIGN FLOW 360 L.T.A.R. 0.30 GPD/FT²

Septic Tank: 1000 Gallons; STB 1012 Date 7-29-96
Pump Tank: Gallons; PT Date
Pump Make: Model Serial No.
Nitrification Field: No Fields 1 Square Feet 1200 Linear Feet 400
No Lines 6 Trench Width 36" Max Trench Bottom Depth 18-36 Gravel Depth 12"

☑ New System ☐ Repair System Type: I II III IV V VI
System Description: CONVENTIONAL GRAVITY
Repair System Description: CHAMBERED GRAVITY
Maintenance Agreement Required: ☐ Yes ☑ No

☑ House/Mod. Home No. Bedrooms 3
☐ Mobile Home No. Bathrooms 2
☐ Business No. Employees
☐ Other


☐ Slab ☑ Crawl Space ☐ Basement w/plumbing ☐ Basement wo/plumbing

Water Supply: ☑ Individual ☐ Community ☐ Public WELL

Comments: KEEP SYSTEM MINIMUM 100' FROM WELL.

Comments:

INITIAL SITE SKETCH

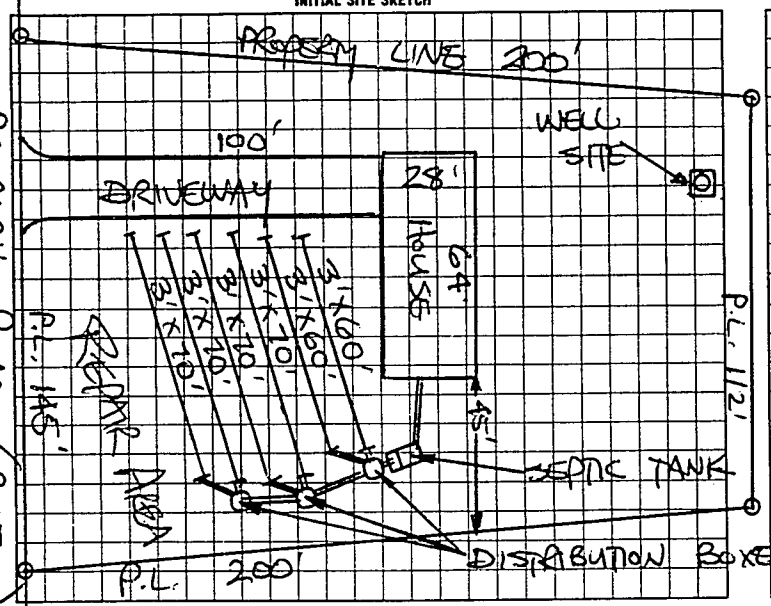

AS BUILT SKETCH

SYSTEM INSTALLED ACCORDING TO INITAL SITE SKETCH

I understand that this permit can be suspended or revoked if any false information is supplied toward securing the permit/any unauthorized changes are made to the site/any unauthorized changes are made in the installation of the system. Authorization to Construct is valid five (5) years from date of issuance. Improvement Permit has no expiration date.

Signed: X K. Lee Hartline Installed by: A-1 BACKHOE

Improvement Permit by: STEVE HEDRICK date 7-20-96 Certificate of Completion by: date

Final Approval by: STEVE HEDRICK date 7-20-96 Operation Permit by: STEVE HEDRICK date 11-13-96

AUTHORIZATION TO CONSTRUCT:

HEALTH DEPT. COPY WHITE INSPECTION COPY (FINAL) GREEN OWNER COPY (FINAL) YELLOW INSPECTION COPY (INITIAL) PINK OWNER COPY (INITIAL) GOLD

19000