IREDELL COUNTY HEALTH DEPARTMENT

STATESVILLE 704-878-5305 MOORESVILLE 704-664-5281

IMPROVEMENT PERMIT / CERTIFICATE OF COMPLETION / OPERATION PERMIT / EXISTING SYSTEM INSPECTION

PROPERTY DESCRIPTION NO. 257H 66836 DATE 12-23-96 TAX MAP NO. 14B-1-A-31 Watershed: ☐ Yes ☒ No

OWNER OR CONTRACTOR RICHARD JOHNSTON PHONE: Business _____ Home 878-9534

ADDRESS 324 ELMWOOD ROAD, STATESVILLE, NC 28677

LOCATION NC115N, TL PISGAH RD TL TREEBARK RD, TL LUCY LANE 2ND LOT ON RIGHT

SUBDIVISION TREEBARK ACRES BLOCK / SECTION _____ LOT 31 LOT AREA 2.339 ACRES SITE CLASS. PS DESIGN FLOW 360 L.T.A.R. 0.30 GPD/FT²

Septic Tank: 1000 Gallons; STB 1012 Date 6-10-97

Pump Tank: _____ Gallons; PT _____ Date _____

Pump Make: _____ Model _____ Serial No. _____

Nitrification Field: No Fields 1 Square Feet 1200 Linear Feet 400

No Lines FIVE Trench Width 36" Max Trench Bottom Depth 36" Gravel Depth 12"

☒ New System ☐ Repair System Type: I, II, III, IV, V, VI

System Description: CONVENTIONAL GRAVITY

Repair System Description: CONV. PUMP

Maintenance Agreement Required: ☐ Yes ☒ No

☒ House/Mod. Home No. Bedrooms 3

☐ Mobile Home No. Bathrooms 2

☐ Business No. Employees ____

☐ Other _____


☐ Slab ☒ Crawl Space ☐ Basement w/plumbing ☐ Basement wo/plumbing

Water Supply: ☒ Individual ☐ Community ☐ Public WELL


Comments: KEEP SYSTEM MINIMUM 100' FROM WELL

Comments:

INITIAL SITE SKETCH

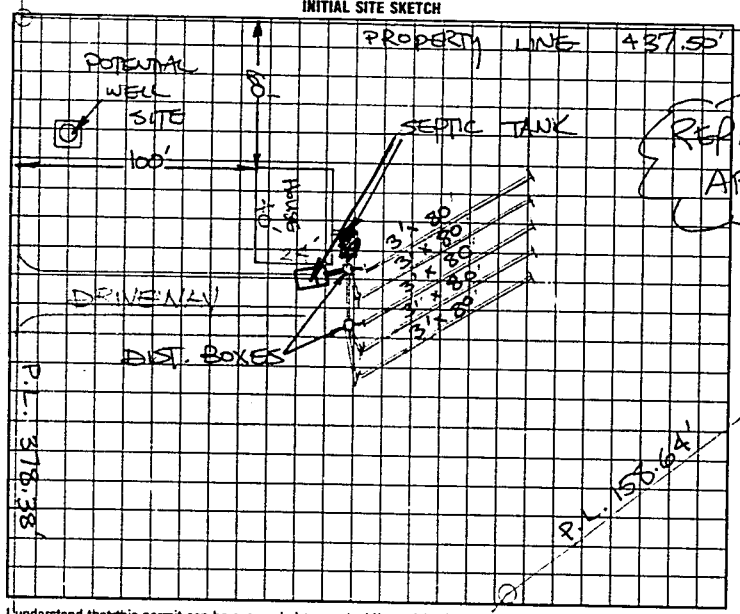

AS BUILT SKETCH

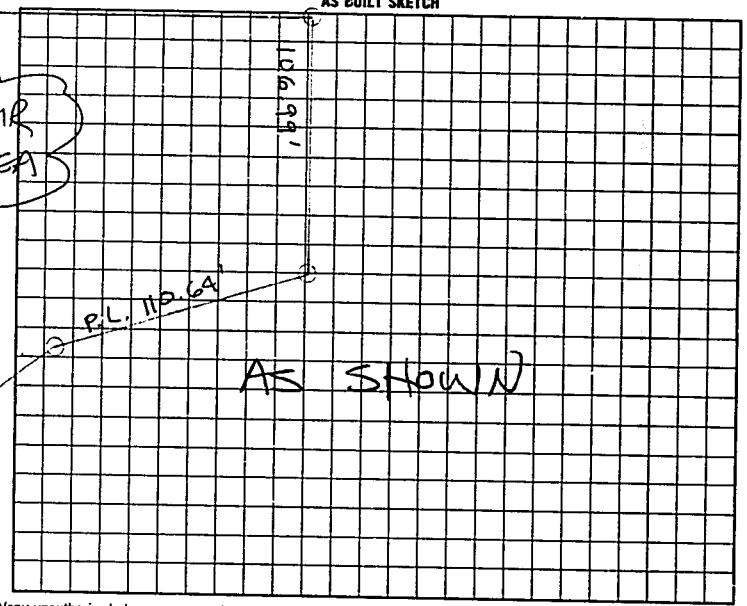

I understand that this permit can be suspended or revoked if any false information is supplied toward securing the permit/any unauthorized changes are made to the site/any unauthorized changes are made in the installation of the system. Improvement Permit is valid for 60 months from date of issuance. AUTH. TO CONST. IS VALID FOR 60 MONTHS.

Signed: X Richard C Johnston

Improvement Permit by: STEVE HEDRICK date 12-23-96

AUTH. TO CONST. Existing System Inspection by: STEVE HEDRICK date 12-23-96

Installed by: KENNY MADISON

Certificate of Completion by: _____ date _____

Operation Permit by: STEVE HEDRICK date 8-20-97

HEALTH DEPT COPY WHITE INSPECTION COPY (FINAL) GREEN OWNER COPY (FINAL) YELLOW INSPECTION COPY (INITIAL) PINK OWNER COPY (INITIAL) GOLD