IREDELL COUNTY HEALTH DEPARTMENT

CI — STATESVILLE 704-878-5305 — MOORESVILLE 704-664-5281

IMPROVEMENT PERMIT / AUTHORIZATION TO CONSTRUCT / OPERATION PERMIT / EXISTING SYSTEM INSPECTION

PERMIT# 112623 PIN# 4728-06-1999 DATE 7-5-03

OWNER OR CONTRACTOR LLOYD D. MYERS PHONE: Business 704-902-4123 Home 704-871-9547

ADDRESS 145 BARRINGER DRIVE STATESVILLE NC 28625

LOCATION NC 115 N TL PISGAH 'ROAD, TR 'BARRINGER DRIVE, 4th LOT ON LEFT

SUBDIVISION BARRINGTON BLOCK / SECTION ____ LOT 4 LOT AREA 2.611 ACRES SITE CLASS. PS DESIGN FLOW 360 L.T.A.R. 0.25 GPD/FT2

Septic Tank: 1000 Gallons; STB 1012 Date 3-16-03

Pump Tank: ____ Gallons; PT ____ Date ____

Pump Make: ____ Model ____ Serial No. ____

Nitrification Field: No Fields 1 Square Feet 1440 Linear Feet 480

No Lines FIVE Trench Width 36" Max Trench Bottom Depth 36" Gravel Depth 12"

☑ New System ☐ Repair System Type: I (II) III, IV, V, VI

System Description: CONVENTIONAL GRAVITY

Repair System Description: CONVENTIONAL GRAVITY

Maintenance Agreement Required: ☐ Yes ☑ No

☑ House/Mod. Home No. Bedrooms 3

☐ Mobile Home No. Bathrooms 2

☐ Business No. Employees ____

☐ Other ____


☐ Slab ☑ Crawl Space ☐ Basement w/plumbing ☐ Basement wo/plumbing

Water Supply: ☑ Individual ☐ Public ☐ Community WELL


Comments:/Conditions: KEEP SYSTEM MINIMUM 100 FEET FROM WELL

Comments:/Conditions: TUFF TITE FILTER MARKER. WELL CHANGED TO FRONT LEFT CORNER. WELL IS 98' FROM SEPTIC TANK. NO SAPROLITE ON SOIL SHEET SO APPROVED CHANGE. NEIGHBORS WELL IS 80' FROM SEPTIC TANK, PULLED OLD PERMIT & NO SAPROLITE LISTED ON LOT #3 SOIL SHEET EITHER. THE WELL ON LOT #3 IS INSTALLED AS DRAWN, 80' FROM NEIGHBORS WELL. LL 10-1-03

INITIAL SITE SKETCH

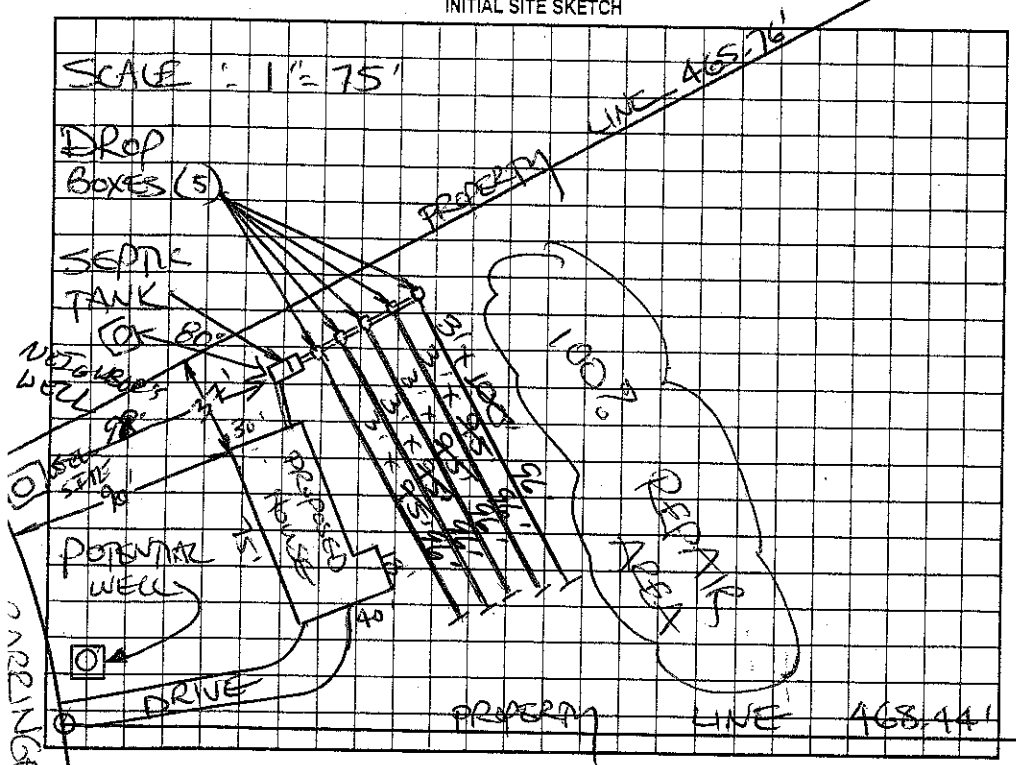

AS BUILT SKETCH

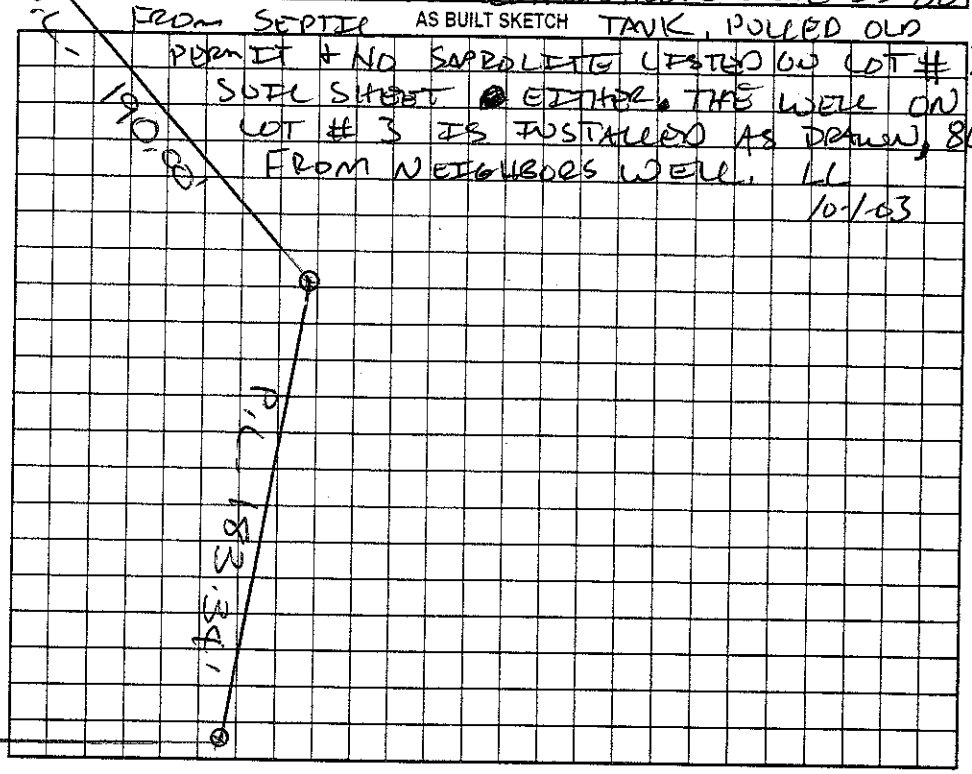

Permit can be suspended or revoked if any false information is supplied toward securing the permit/any unauthorized changes are made to the site/any unauthorized changes are made in the installation of the system. Improvement Permit with plat valid without expiration. Improvement Permit with site plan valid for sixty months. Authorization to Construct is valid for a period equal to that of Improvement Permit – not to exceed sixty months.

Signed: ____ date 7-7-03 Installed by: DAVID YOUNTZ

Improvement Permit by: STEVE HEDRICK date 7-5-03 Operation Permit by: ____ date 10-1-03

Authorization to Construct by: STEVE HEDRICK date 7-5-03 Existing System Inspection by: ____ date ____

HEALTH DEPT. COPY: WHITE OWNER COPY (FINAL): YELLOW OWNER COPY (INITIAL): PINK