THIS PERMIT VOIDS PREVIOUS ISSUED 7-21-1999

IREDELL COUNTY HEALTH DEPARTMENT

STATESVILLE 704-878-5305 (C) MOORESVILLE 704-664-5281

IMPROVEMENT PERMIT / AUTHORIZATION TO CONSTRUCT / OPERATION PERMIT / EXISTING SYSTEM INSPECTION

PERMIT# 082363 PIN# 4728-07-5110 DATE 8-16-02

OWNER OR CONTRACTOR JIM NELSON PHONE: Business Home (704) 902-9618

ADDRESS 161 BARRINGER DR STATESVILLE NC 28625

LOCATION 115 N TO PISGAH ROAD TR BARRINGER DR, 6TH LOT ON LEFT

SUBDIVISION BARRINGTON BLOCK / SECTION LOT 6 LOT AREA 1.9 ACRES SITE CLASS PS DESIGN FLOW 360 L.T.A.R. 0.30 GAD/SQ FT

Septic Tank: 1000 Gallons: STB 1012 Date 5-3-02
Pump Tank: Gallons: PT Date
Pump Make: Model Serial No
Nitrification Field: No Fields 4 Square Feet 1200 Linear Feet 400
No Lines FOUR Trench Width 36" Max Trench Bottom Depth 36" Gravel Depth 12"

~~New System~~ Repair System Type: I (II) III IV V VI
System Description: CONVENTIONAL GRAVITY
Repair System Description: CONVENTIONAL GRAVITY
Maintenance Agreement Required: Yes ~~No~~
Slab ~~Crawl Space~~ Basement w/plumbing Basement wo/plumbing


~~House/Mod. Home~~ No. Bedrooms 3
Mobile Home No. Bathrooms
Business No. Employees
Other

Water Supply: ~~Individual~~ Public Community
WELL


Comments:/Conditions:

Comments:/Conditions: SEPTIC TANK WITH MARKER INSTALLED USING "POLY LOK" FILTER

INITIAL SITE SKETCH SCALE: 1" = 60'

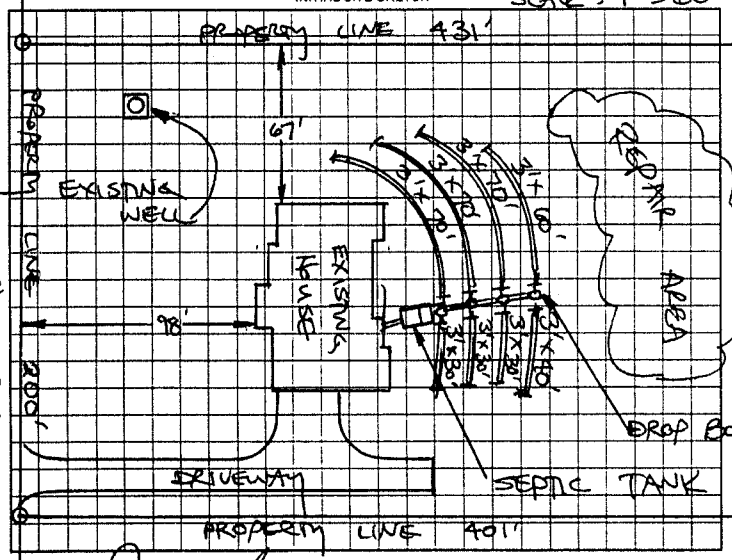

AS BUILT SKETCH

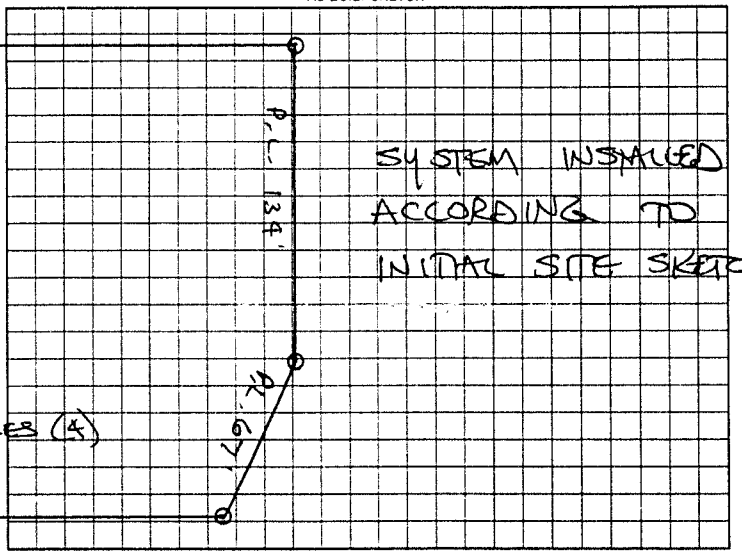

Permit can be suspended or revoked if any false information is supplied toward securing the permit/any unauthorized changes are made to the site/any unauthorized changes are made in the installation of the system. Improvement Permit with plat valid without expiration. Improvement Permit with site plan valid for sixty months. Authorization to Construct is valid for a period equal to that of Improvement Permit – not to exceed sixty months

Signed: X Jim Nelson date 8/16/2002 Installed by STEVE JORDAN

Improvement Permit by: STEVE HEDRICK date 8-16-02 Operation Permit by: STEVE HEDRICK date 8-16-02

Authorization to Construct by: STEVE HEDRICK date 8-16-02 Existing System Inspection by: date

HEALTH DEPT COPY: WHITE OWNER COPY (FINAL): YELLOW OWNER COPY (INITIAL): PINK