IREDELL COUNTY HEALTH DEPARTMENT

STATESVILLE 704-878-5305 (C) MOORESVILLE 704-664-5281

IMPROVEMENT PERMIT / AUTHORIZATION TO CONSTRUCT / OPERATION PERMIT / EXISTING SYSTEM INSPECTION

PERMIT# 103948 PIN# 4728-07-3798 AND 4728-07-4968 DATE 1-14-02

OWNER OR CONTRACTOR TIMOTHY ALEXANDER PHONE: Business 704-876-1653 Home

ADDRESS 302 TREEBARK ROAD, STATESVILLE NC 28625

LOCATION NC 115 N, TL PISGAH RD, TR BARRINGTON DRIVE, LOTS # 8 & 9 AT END ON LEFT

SUBDIVISION BARRINGTON EST. BLOCK / SECTION LOT 8 & 9 LOT AREA 3.513 ACRE (TOTAL) SITE CLASS PS DESIGN FLOW 360 L.T.A.R. 0.30 GPD/FT²

Septic Tank: 1000 Gallons. STB 1012 Date 3-3-02
Pump Tank: Gallons. PT Date
Pump Make: Model Serial No.
Nitrification Field: No Fields 1 Square Feet EQ. TO 1200 Linear Feet 300
No Lines FOUR Trench Width 36" Max Trench Bottom Depth 36" Gravel Depth N/A

☑ New System ☐ Repair System Type: I. II (III) IV. V. VI
System Description: 25% REDUCTION, GRAVITY
Repair System Description 25% REDUCTION, GRAVITY
Maintenance Agreement Required: ☐ Yes ☑ No
☐ Slab ☐ Crawl Space ☑ Basement w/plumbing ☐ Basement w/o plumbing

☑ House/Mod. Home No. Bedrooms 2
☐ Mobile Home No. Bathrooms 2
☐ Business No. Employees
☐ Other FUTURE 3BR


Water Supply: ☑ Individual ☐ Public ☐ Community
WELL

Comments/Conditions: ① INSTALL 25% REDUCTION SYSTEM ON CONTOUR AS SHOWN ② KEEP SYSTEM MINIMUM 100 FEET FROM


Comments/Conditions SEPTIC TANK WITH RISERS INSTALLED USING "POLYLOK" FILTER

SCALE: 1" = 60'

INITIAL SITE SKETCH

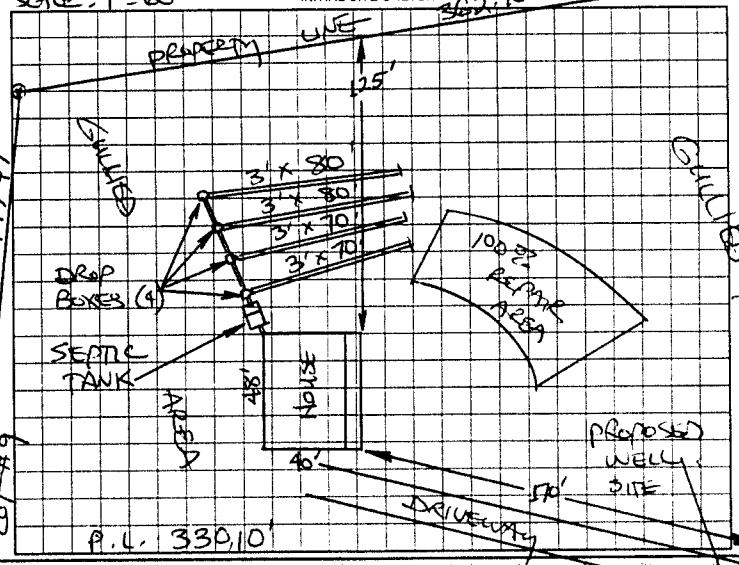

AS BUILT SKETCH

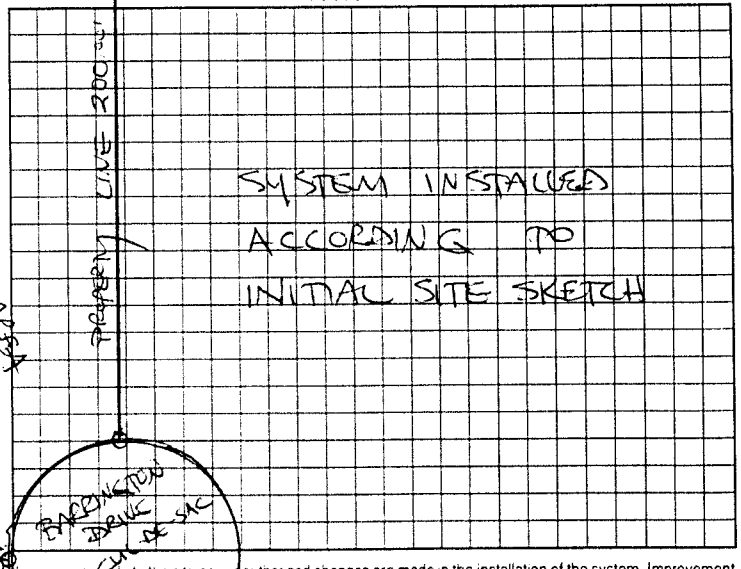

Permit can be suspended or revoked if any false information is supplied toward securing the permit; any unauthorized changes are made to the site; any unauthorized changes are made in the installation of the system. Improvement Permit with plat valid without expiration. Improvement Permit with site plan valid for sixty months. Authorization to Construct is valid for a period equal to that of Improvement Permit - not to exceed sixty months.

Signed: Tam Alexander date 1-15-02 ⓞ Installed by: DAVID YOUNTZ w/PATRICK MITCHELL

Improvement Permit by: STEVE HENDRICK date 1-14-02 Operation Permit by: STEVE HENDRICK date 4-29-02

Authorization to Construct by: STEVE HENDRICK date 1-14-02 Existing System Inspection by: date

HEALTH DEPT COPY WHITE OWNER COPY (FINAL) YELLOW OWNER COPY (INITIAL) PINK