IREDELL COUNTY HEALTH DEPARTMENT

STATESVILLE 704-878-5305 MOORESVILLE 704-664-5281

IMPROVEMENT PERMIT / AUTHORIZATION TO CONSTRUCT / OPERATION PERMIT / EXISTING SYSTEM INSPECTION

PERMIT# 137984 PIN# 4728077503 DATE 5 October 06

OWNER OR APPLICANT Standard Building Co., Inc. PHONE: Business 704-902-4618 Home 704-876-1984

ADDRESS 161 Barringer Drive Statesville, N.C.

LOCATION 170 Barringer Drive Statesville, N.C.

SUBDIVISION Barringer Estates BLOCK / SECTION ____ LOT 12 LOT AREA 1.146 Ac. SITE CLASS. #3 DESIGN FLOW 360 gpd L.T.A.R. 0.3 gpd/Ft²/day

Septic Tank: 1000 Gallons; STB TP STB1012 Date 2-12-07

Pump Tank: ____ Gallons; PT ____ Date ____

Pump Make: ____ Model ____ Serial No. ____

Nitrification Field: No Fields 1 Square Feet 1200 Linear Feet 300

No Lines 4 Trench Width 3' Max Trench Bottom Depth 36" Gravel Depth #4

☑ New System ☐ Repair ☐ Expansion System Type: I (II) III IV V VI

System Description: 25% Reduction System

Repair System Description: 25% Reduction System

Maintenance Agreement Required: ☐ Yes ☐ No

☑ Gravity ☐ Pressure ☐ Slab ☑ Crawl Space ☐ Basement w/plumbing ☐ Basement wo/plumbing

☑ House/Mod. Home No. Bedrooms 3

☐ Mobile Home No. Persons ____

☐ Business No. Employees ____


☐ Other ____

Water Supply: ☑ Individual ☐ Public ☐ Community

Comments/Conditions: use Accepted system / Follow contours 1"=60' + use 4 Drop-boxes

Comments/Conditions: Filter installed / Tank has MARKER

INITIAL SITE SKETCH

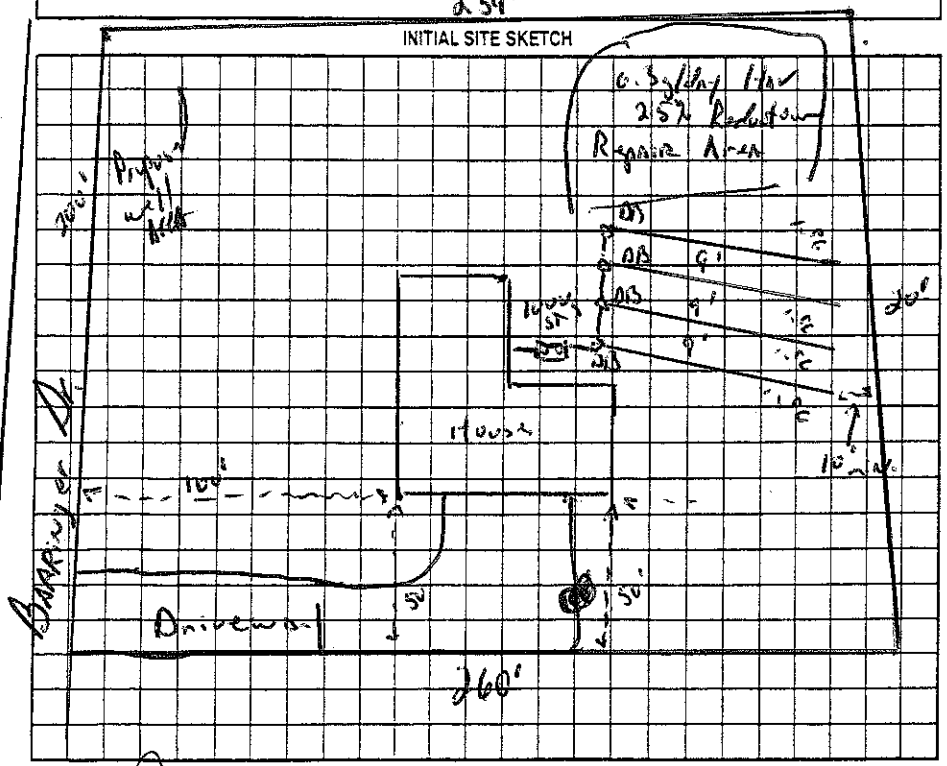

AS BUILT SKETCH

Install As Drawn

Permit can be suspended or revoked if any false information is supplied toward securing the permit/any unauthorized changes are made to the site/any unauthorized changes are made in the installation of the system. Improvement Permit with plat valid without expiration. ☐ Improvement Permit with site plan valid for sixty months ☐ Authorization to Construct is valid for a period equal to that of Improvement Permit – not to exceed sixty months.

Signed: [signature] date 10/16/06

Improvement Permit by: [signature] R.S. date 5 Oct. 06

Authorization to Construct by: [signature] R.S. date 5 Oct. 06

Installed by: Steve JORDON

Operation Permit by: [signature] R.S. date 10 Nov 07

Existing System Inspection by: ____ date ____

HEALTH DEPT. COPY: WHITE OWNER COPY (FINAL): YELLOW OWNER COPY (INITIAL): PINK