IREDELL COUNTY HEALTH DEPARTMENT

STATESVILLE 704-878-5305 MOORESVILLE 704-664-5281

IMPROVEMENT PERMIT / AUTHORIZATION TO CONSTRUCT / OPERATION PERMIT / EXISTING SYSTEM INSPECTION

PERMIT# 17362 PIN# 4728 21 3726 DATE 3-13-98

OWNER OR CONTRACTOR Ashley R Byers PHONE: Business Home 876 1193

ADDRESS 172 Flat Bed Dr.

LOCATION 115 N TL Midway Dr. TR Cove Gap Rd at end on left

SUBDIVISION BLOCK / SECTION LOT LOT AREA 3.0 acres SITE CLASS PS DESIGN FLOW 360 L.T.A.R. .35

Septic Tank: Gallons; STB Date

Pump Tank: Gallons; PT Date

Pump Make: Model Serial No.

Nitrification Field: No Fields 1 Square Feet 360 Linear Feet 1080

No Lines 17 Trench Width 36" Max Trench Bottom Depth 24" Gravel Depth 22"

☐ New System ☐ Repair System Type: I, II, III, IV, V, VI

System Description: Con Gravity

Repair System Description: Gravity 25% Red

Maintenance Agreement Required: ☐ Yes ☐ No

☐ House/Mod. Home No. Bedrooms 3

☐ Mobile Home No. Bathrooms 2

☐ Business No. Employees

☐ Other


☑ Slab ☐ Crawl Space ☐ Basement w/plumbing ☐ Basement wo/plumbing

Water Supply: ☑ Individual ☐ Public ☐ Community


Comments/Conditions:

Comments/Conditions: As Built Sketch

INITIAL SITE SKETCH

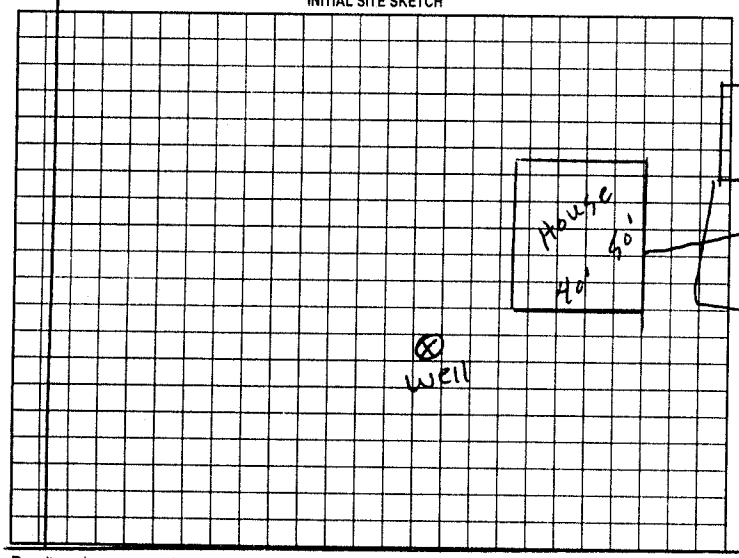

AS BUILT SKETCH

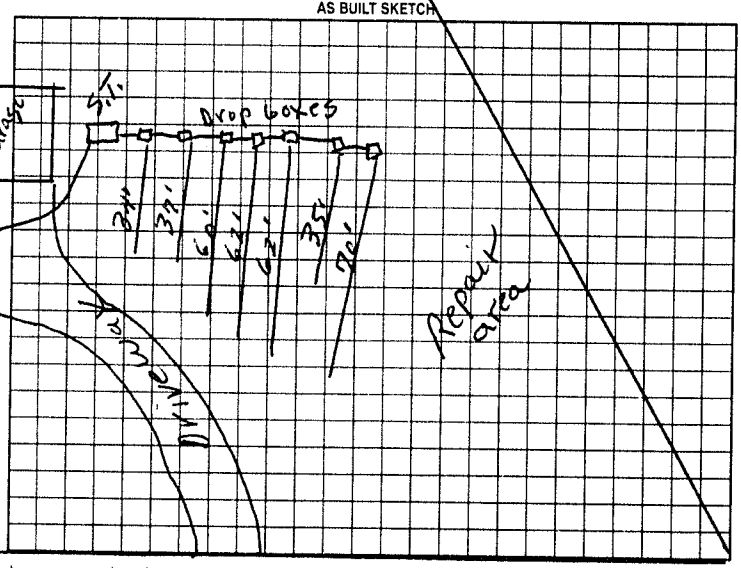

Permit can be suspended or revoked if any false information is supplied toward securing the permit/any unauthorized changes are made to the site/any unauthorized changes are made in the installation of the system. Improvement Permit with plat valid without expiration. Improvement Permit with site plan valid for sixty months. Authorization to Construct is valid for a period equal to that of Improvement Permit – not to exceed sixty months.

Signed: X [illegible] date Installed by: Ashley Ryan Byers

Improvement Permit by: P.C. Moore date 3-13-98 Operation Permit by: P.C. Moore date 1-13-99

Authorization to Construct by: P.C. Moore date 3-13-98 Existing System Inspection by: date

HEALTH DEPT. COPY: WHITE OWNER COPY (FINAL) YELLOW OWNER COPY (INITIAL) PINK