IREDELL COUNTY HEALTH DEPARTMENT

Statesville Office (704) 878-5305 Mooresville Office (704) 660-3625 PERMIT # 221300

IMPROVEMENT PERMIT / AUTHORIZATION TO CONSTRUCT / OPERATION PERMIT / EXISTING SYSTEM

PIN # 4728121558

APPLICANT: ROLLANS SOIL APPLICANT ADDRESS: 275 Treebark Rd Statesville NC 28625

SITE ADDRESS: 275 TREEBARK RD STATESVILLE 28625 PHONE: ALT. PHONE:

SITE DIRECTIONS: 115N - TL PESGAH TL TREEBARK - ON LEFT


SUBDIVISION: WATSON FARM SECTION: LOT # 10 LOT AREA: 1.64AC DESIGN FLOW: 600 L.T.A.R.: .3

Septic Tank	1500 New (gal)	STB	964	Date	9-5-16	☑ New System ☐ Repair ☐ Expansion	System Type: I II (III) IV V VI	☑ Residence	No. Bedrooms	5	Water Supply
Pump Tank	(gal)	PT		Date		System Description:	GRAVITY CONVENTIONAL + 25%	☐ Business	No. Persons	10	☑ Private
Pump Make		Model		Serial #		Repair System Description:	PUMP/GRAVITY 25%	☐ Other	No. Employees		☐ Public
# Nitrification Fields	1	# Lines	6	Linear Ft:	200 New	Maintenance Agreement Required:	☐ YES ☑ NO	☐ Slab	☐ Crawl Space		☐ Community
Trench Width	36"	Max. Trench Bottom Depth	36"	Gravel Depth	N/A	☑ GRAVITY	☐ PRESSURE	☑ Basement w/plumbing			☐ Basement w/o plumbing

Comments / Conditions:

600 TOTAL

INITIAL SITE SKETCH

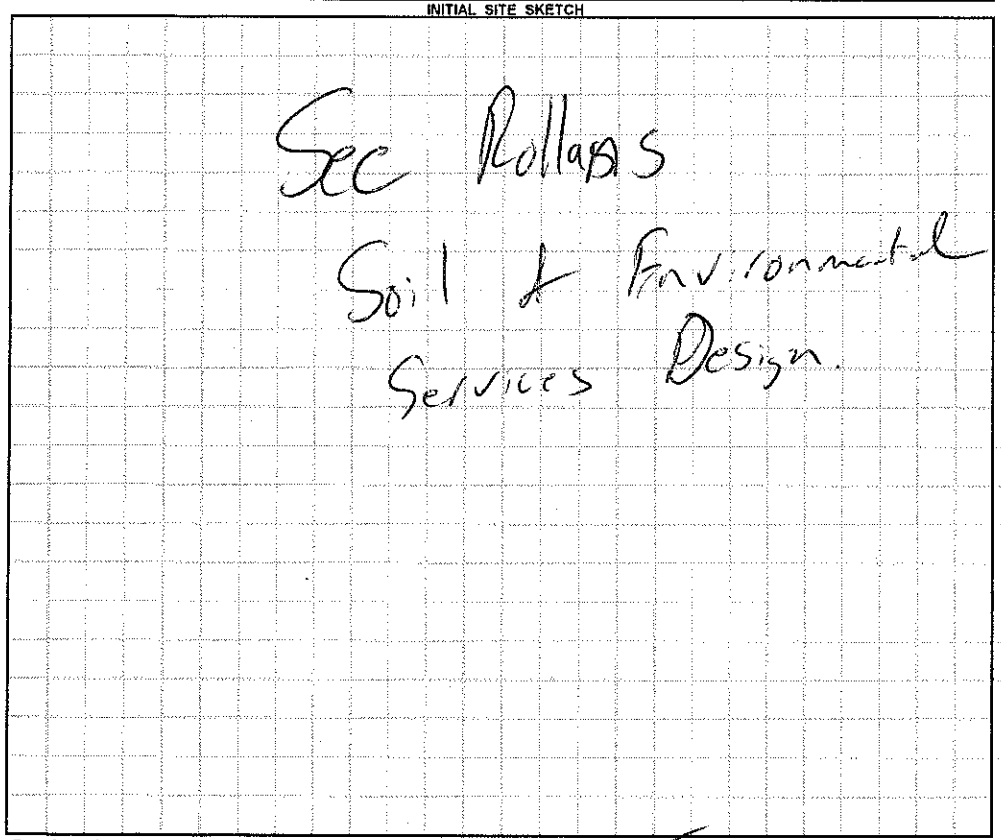

AS BUILT SKETCH

Permit can be suspended or revoked if any false information is supplied toward securing the permit / any unauthorized changes are made to the site / any unauthorized changes are made in the installation of the system. **CONTACT A LOCATOR SERVICE PRIOR TO ANY EXCAVATION**


☐ **IMPROVEMENT PERMIT** ***with plat*** *valid without expiration.* ☑ **IMPROVEMENT PERMIT** ***with site plan*** *valid for 60 mos.* ☑ **AUTHORIZATION TO CONSTRUCT** *valid for period equal to IMPROVEMENT PERMIT--not to exceed 60 mo.*

Owner / Applicant Signature: Date: 9.9.16 Installed by: Al Beatty

IMPROVEMENT PERMIT by: Date: 9/8/16 OPERATION PERMIT by: Date: 10/12/16

AUTHORIZATION TO CONSTRUCT by: Date: 09/12/16 Existing System Inspected by: Date:

Health Dept. Copy - WHITE Applicant (Final Approval) - YELLOW Applicant (Conditional Approval) - PINK

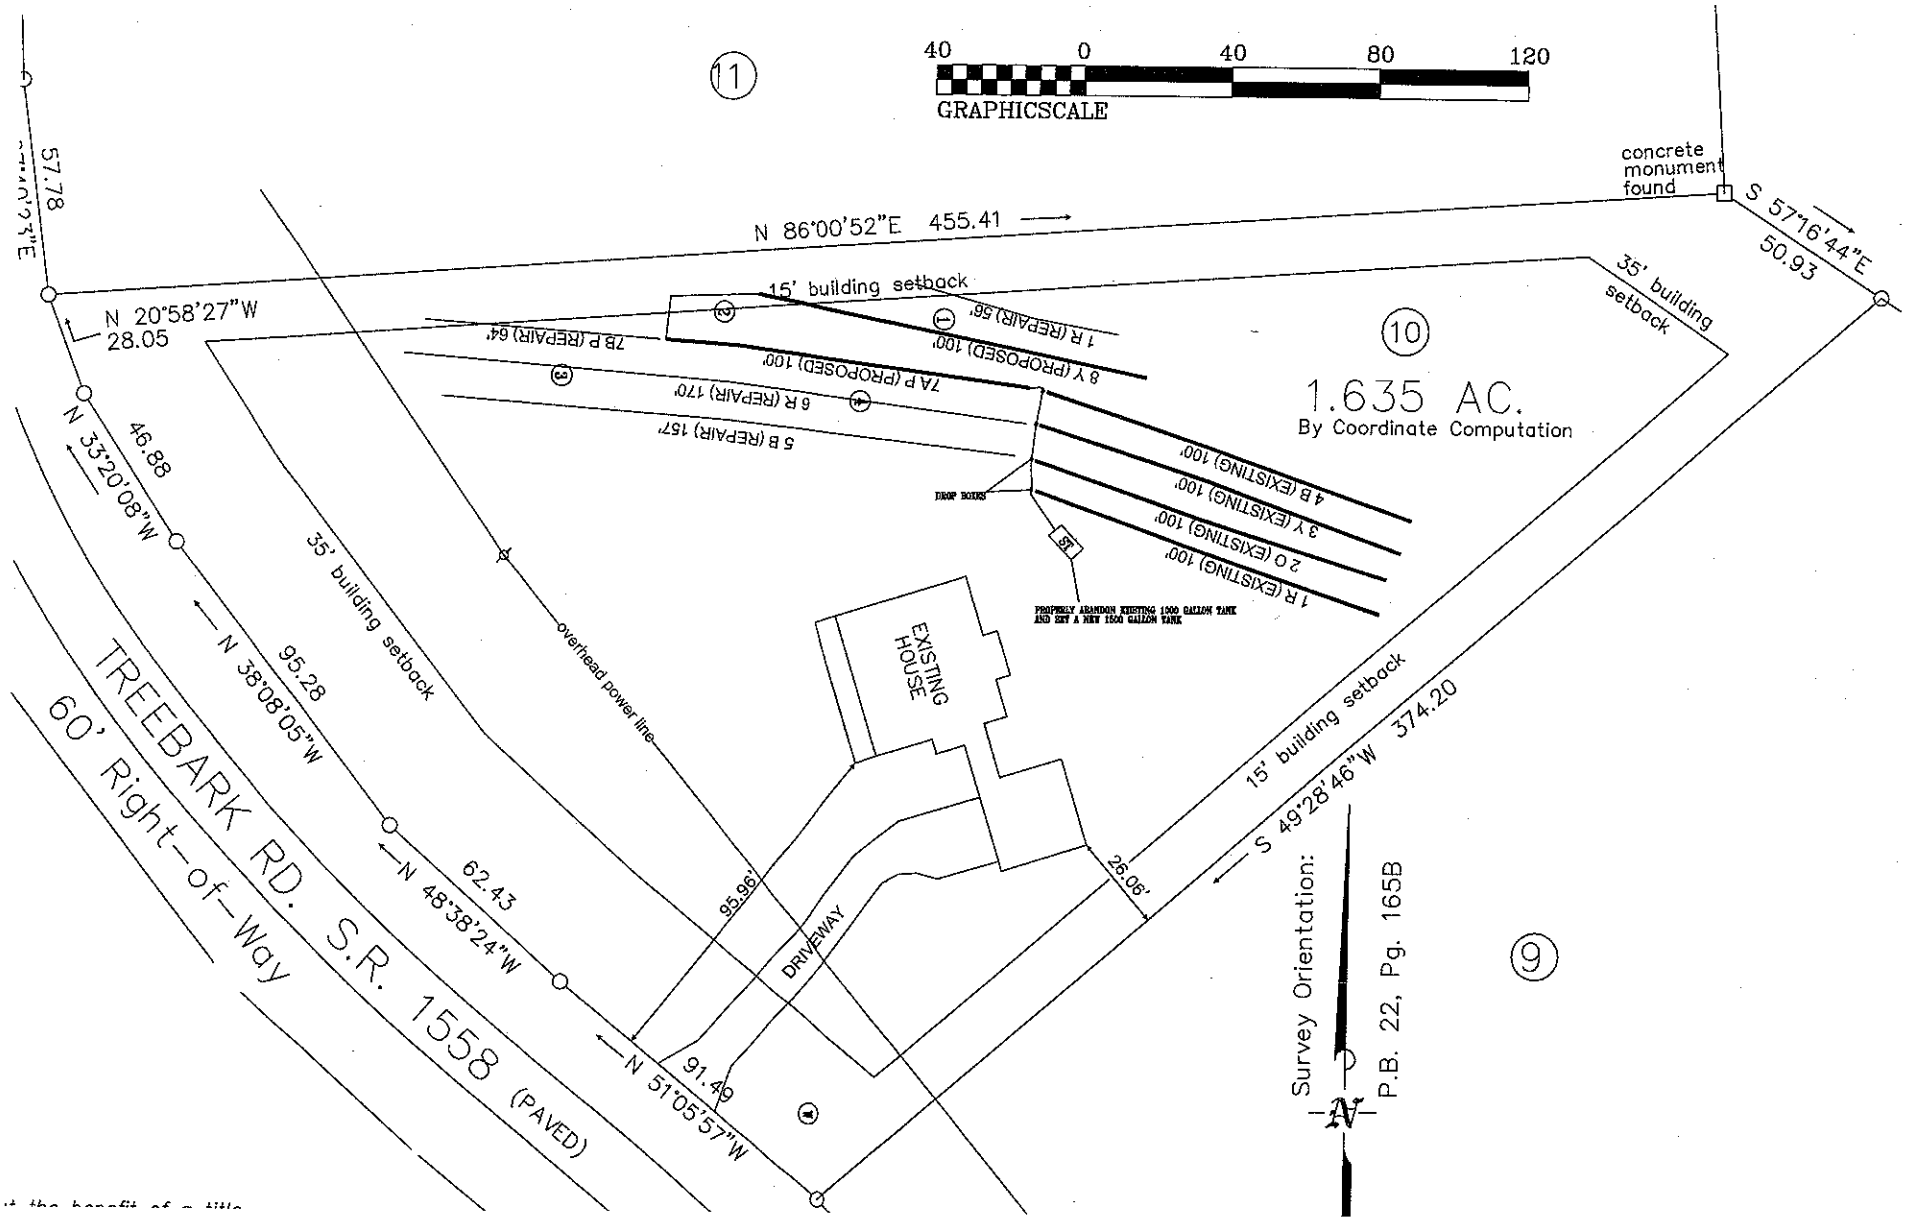
11
40 0 40 80 120
GRAPHICSCALE
57.78
N 20°58'27"W
28.05
N 86°00'52"E 455.41
concrete monument found
S 57°16'44"E
50.93
35' building setback
15' building setback
10
1.635 AC.
By Coordinate Computation
7B P (REPAIR) 64'
7A P (PROPOSED) 100'
6 R (REPAIR) 170'
5 B (REPAIR) 157'
8 Y (PROPOSED) 100'
1 R (REPAIR) 56'
4 B (EXISTING) 100'
3 Y (EXISTING) 100'
2 O (EXISTING) 100'
1 R (EXISTING) 100'
DROP BOXES
PROPERLY ABANDON EXISTING 1000 GALLON TANK AND SET A NEW 1500 GALLON TANK
EXISTING HOUSE
overhead power line
DRIVEWAY
N 33°20'08"W
46.88
N 38°08'05"W
95.28
N 48°38'24"W
62.43
N 51°05'57"W
91.49
95.96'
26.06'
S 49°28'46"W 374.20
TREEBARK RD. S.R. 1558 (PAVED)
60' Right-of-Way
9
Survey Orientation:
P.B. 22, Pg. 165B
N