IREDELL COUNTY HEALTH DEPARTMENT

Statesville Office (704) 878-5305 Mooresville Office (704) 660-3625 PERMIT # 217479

IMPROVEMENT PERMIT / AUTHORIZATION TO CONSTRUCT / OPERATION PERMIT / EXISTING SYSTEM

PIN # 4728124452

APPLICANT: William Robinson APPLICANT ADDRESS: 295 Treebark Rd.

SITE ADDRESS: 295 Treebark Rd. PHONE: 704-380-9425 ALT. PHONE: 434-454-6643


SITE DIRECTIONS: Hwy 115 N TL Pisgah Church Rd. TL Treebark. Property @ end on left

SUBDIVISION: Watson Farms SECTION: MA LOT # 8-9 LOT AREA: 3.25 acres DESIGN FLOW: 360gpd L.T.A.R.: Existing


Septic Tank	Existing	(gal)	STB		Date	☐ New System	☐ Repair	☐ Expansion	System Type: I II III IV V VI	☑ Residence	No. Bedrooms	3	Water Supply		
Pump Tank		(gal)	PT		Date	System Description:	Existing			☐ Business	No. Persons	6	☑ Private		
Pump Make		Model			Serial #	Repair System Description:	25% Reduction			☐ Other	No. Employees		☐ Public		
# Nitrification Fields	Ex	# Lines	Ex		Linear Ft: Ex	Maintenance Agreement Required:	☐ YES	☑ NO		☐ Slab	☐ Crawl Space		☐ Community		
Trench Width	Ex	Max. Trench Bottom Depth	Ex		Gravel Depth Ex		☑ GRAVITY	☐ PRESSURE		☐ Basement w/plumbing			☐ Basement w/o plumbing		

Comments / Conditions: The Purpose of this permit was to relocated separ area to accomodate the proposed 16'X32' pool and the proposed 32'X36' shop. Orginal operation permit was issued 7-10-01

INITIAL SITE SKETCH

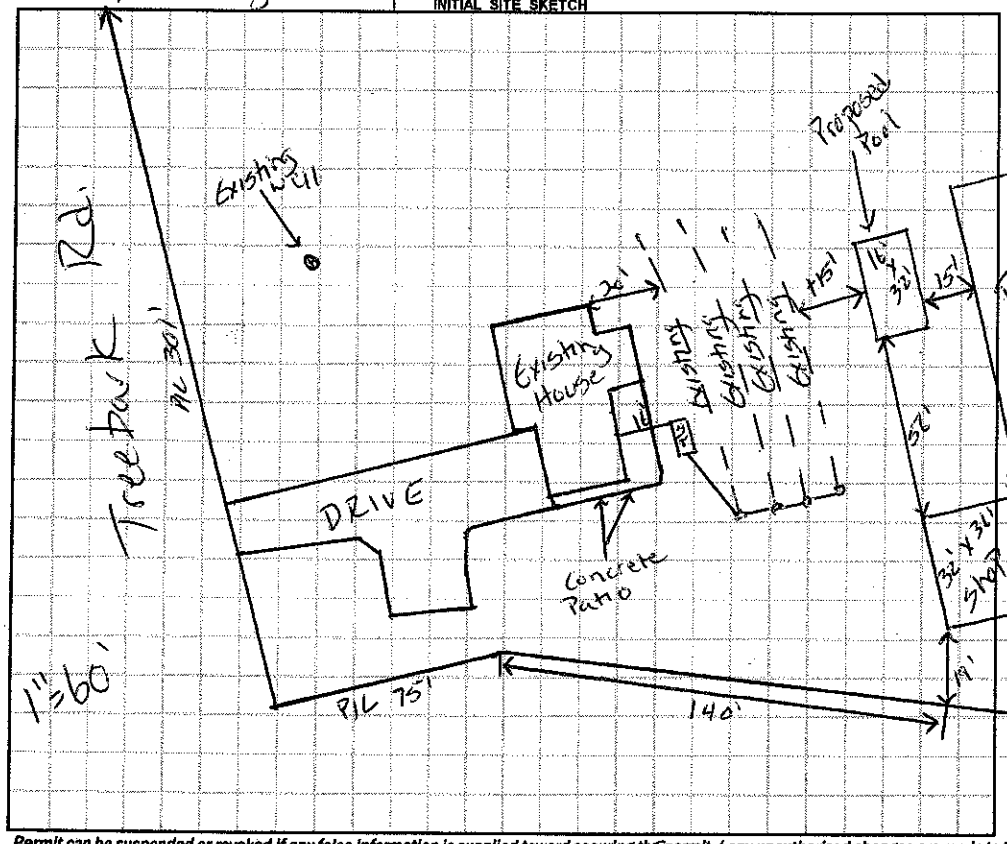

AS BUILT SKETCH

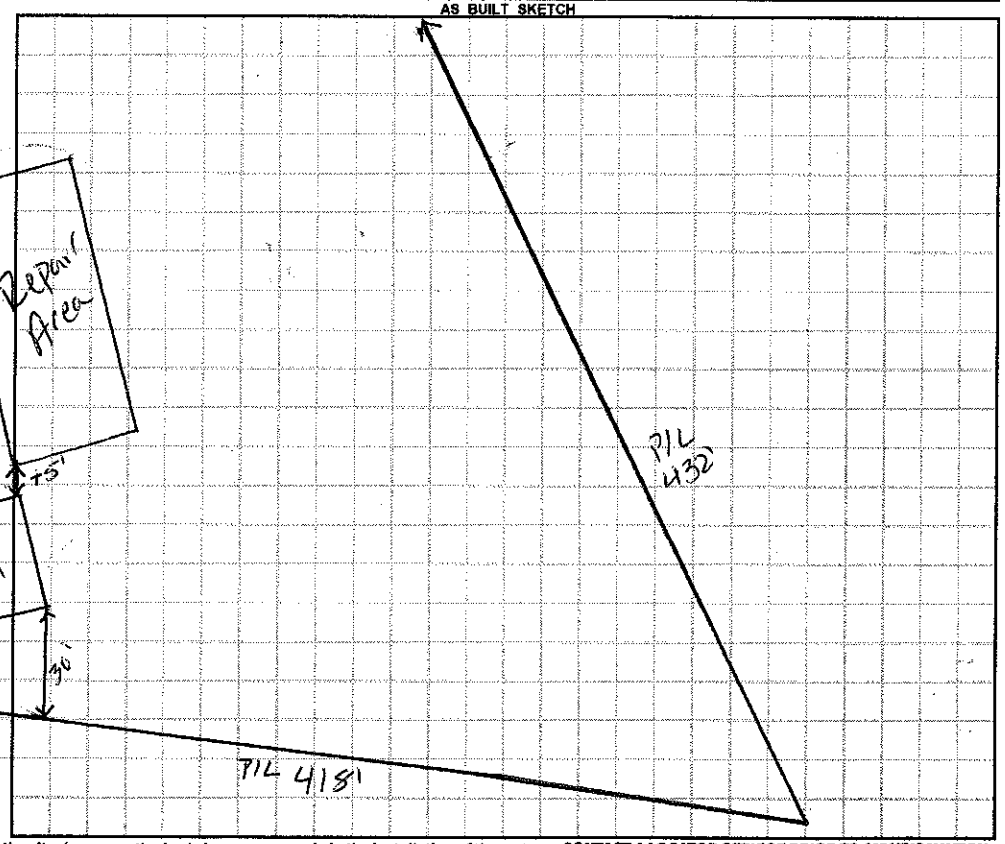

Permit can be suspended or revoked if any false information is supplied toward securing the permit / any unauthorized changes are made to the site / any unauthorized changes are made in the installation of the system. **CONTACT A LOCATOR SERVICE PRIOR TO ANY EXCAVATION**

☐ **IMPROVEMENT PERMIT** *with plat valid without expiration.* ☐ **IMPROVEMENT PERMIT** *with site plan valid for 60 mos.* ☑ **AUTHORIZATION TO CONSTRUCT** *valid for period equal to IMPROVEMENT PERMIT--not to exceed 60 mo.*

Owner / Applicant Signature: William Robinson Date: 5-2-16 Installed by:

IMPROVEMENT PERMIT by: Justin Henderson Date: 4-28-16 OPERATION PERMIT by: Issued by Lorne Cook Date: 7-10-01

AUTHORIZATION TO CONSTRUCT by: Justin Henderson Date: 4-28-16 Existing System Inspected by: Date:

Health Dept. Copy - WHITE Applicant (Final Approval) - YELLOW Applicant (Conditional Approval) - PINK