# IREDELL COUNTY HEALTH DEPARTMENT

STATESVILLE 704-878-5305 MOORESVILLE 704-664-5281

55683

## IMPROVEMENT PERMIT / CERTIFICATE OF COMPLETION / OPERATION PERMIT / EXISTING SYSTEM INSPECTION

PROPERTY DESCRIPTION NO. 20809 DATE 4/18/95 TAX MAP NO. 14B-2-A-12 Watershed: ☐ Yes ☒ No

OWNER OR CONTRACTOR K. W. NICHOLSON, INC. PHONE: Business Home 876-4359

ADDRESS 182 MILLSTONE DR., STATESVILLE, NC 28677

LOCATION NC 115 N, TL PISGAH CH. RD TL TREEBARK ROAD WATSON FARMS LOT #12 ON LEFT

SUBDIVISION WATSON FARMS BLOCK / SECTION LOT 12 LOT AREA 12.3 AC SITE CLASS. PS1 DESIGN FLOW 360 L.T.A.R. 0.336 GPD/FT²

Septic Tank: 1000 Gallons; STB 1012 Date 7/17/95

Pump Tank: Gallons; PT Date

Pump Make: Model Serial No.

Nitrification Field: No Fields 1 Square Feet 1080 Linear Feet 360

No Lines 3 Trench Width 36" Max Trench Bottom Depth 18-36" Gravel Depth 12

☒ New System ☐ Repair System Type: I, II, III, IV, V, VI

System Description: CONVENTIONAL GRAVITY

Repair System Description: CONV. GRAVITY

Maintenance Agreement Required: ☐ Yes ☒ No

☒ House/Mod. Home No. Bedrooms 3

☐ Mobile Home No. Bathrooms 2

☐ Business No. Employees

☐ Other

☐ Slab ☒ Crawl Space ☐ Basement w/plumbing ☐ Basement wo/plumbing


Water Supply: ☒ Individual ☐ Community ☐ Public WELL

Comments: ① KEEP WELL MINIMUM 100' FROM SYSTEM ② INSTALL LINES AS SHOWN, ON CONTOUR, NO DEEPER THAN 36".


Comments:

OFF ROAD ~ 1000'

INITIAL SITE SKETCH

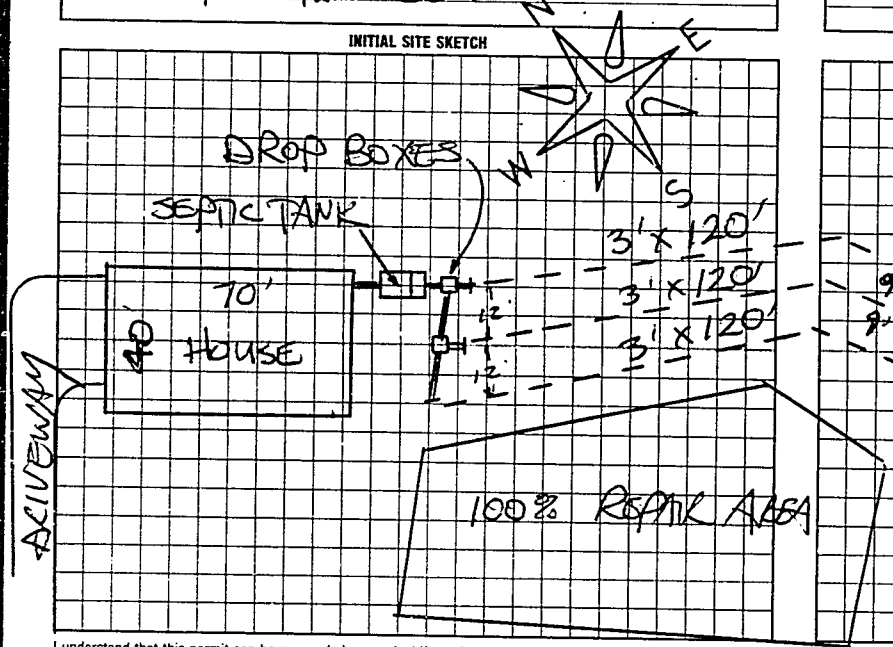


AS BUILT SKETCH

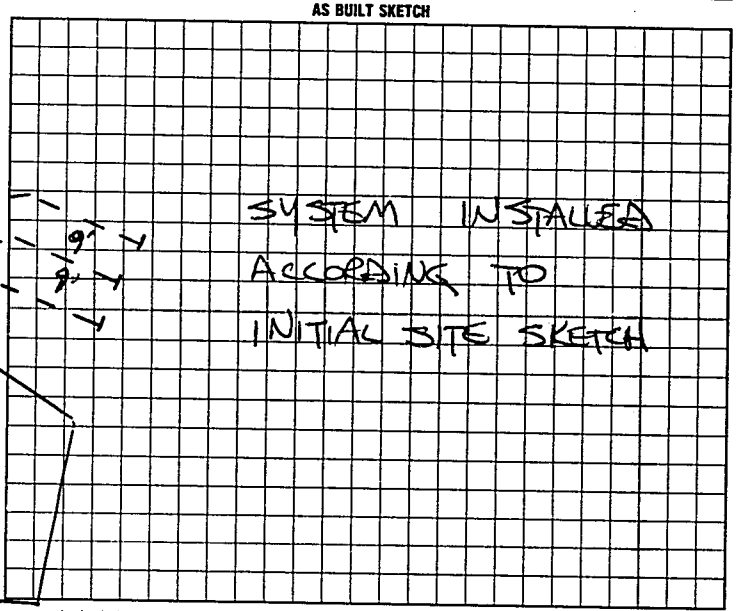


I understand that this permit can be suspended or revoked if any false information is supplied toward securing the permit/any unauthorized changes are made to the site/any unauthorized changes are made in the installation of the system. Improvement Permit is valid for 60 months from date of issuance.

Signed: X K W Nicholson Inc.

Improvement Permit by: STEVE HEDRICK date 4/18/95

Existing System Inspection by: date

Installed by: TOMMY FRYE

Certificate of Completion by: STEVE HEDRICK date 9-20-95

Operation Permit by: date

HEALTH DEPT. COPY: WHITE INSPECTION COPY (FINAL): GREEN OWNER COPY (FINAL): YELLOW INSPECTION COPY (INITIAL): PINK OWNER COPY (INITIAL): GOLD