IREDELL COUNTY HEALTH DEPARTMENT

STATESVILLE 704-878-5305 MOORESVILLE 704-664-5281

IMPROVEMENT PERMIT / CERTIFICATE OF COMPLETION / OPERATION PERMIT / EXISTING SYSTEM INSPECTION

PROPERTY DESCRIPTION NO. 07014 DATE 10-27-97 TAX MAP NO. 4728 13 0726 Watershed: ☐ Yes ☑ No

OWNER OR CONTRACTOR NELLIE ECKLES PHONE: Business Home 546-7960

ADDRESS 110 VAN DRIVE HARMONY NC 28634

LOCATION NC 115 N, TL PISGAH, TL TREEBARK ROAD, 0.15 MILE ON LEFT PAST WOODSDALE DRIVE

SUBDIVISION BLOCK / SECTION LOT LOT AREA 1.76 ACRES SITE CLASS. PS DESIGN FLOW 360 L.T.A.R. 0.35 GPD/FT²

Septic Tank: 1000 Gallons; STB 100' Date 10-9-97

Pump Tank: Gallons; PT Date

Pump Make: Model Serial No.

Nitrification Field: No Fields 1 Square Feet 1035 Linear Feet 345

No Lines FIVE Trench Width 36" Max Trench Bottom Depth 36" Gravel Depth 12"

☑ New System ☐ Repair System Type: I, II, III, IV, V, VI

System Description: CONVENTIONAL GRAVITY

Repair System Description: CONV. GRAVITY

Maintenance Agreement Required: ☐ Yes ☑ No

☐ House/Mod. Home No. Bedrooms 3

☑ Mobile Home No. Bathrooms 2

☐ Business No. Employees

☐ Other


☐ Slab ☑ Crawl Space ☐ Basement w/plumbing ☐ Basement wo/plumbing

Water Supply: ☑ Individual ☐ Community ☐ Public WELL

Comments: KEEP SYSTEM MINIMUM 100' FROM WELLS

Comments:

INITIAL SITE SKETCH SCALE: 1" = 60'

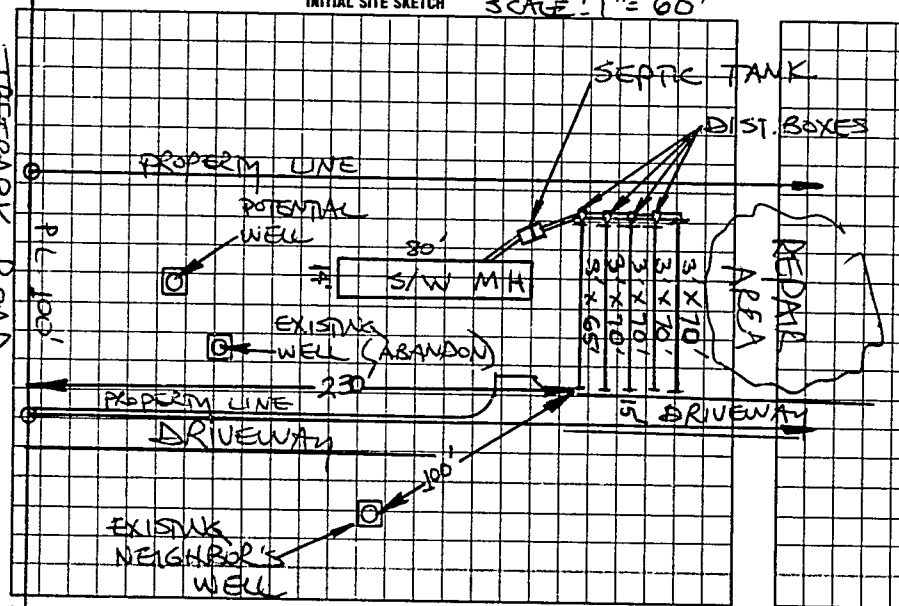

AS BUILT SKETCH

Same as initial Sketch

I understand that this permit can be suspended or revoked if any false information is supplied toward securing the permit/any unauthorized changes are made to the site/any unauthorized changes are made in the installation of the system. Improvement Permit is valid for 60 months from date of issuance. AUTHORIZATION TO CONSTRUCT IS VALID FOR 60 MONTHS FROM DATE OF ISSUANCE.

Signed: Nellie Eckles

Improvement Permit by: STEVE HEDRICK date 10-27-97

AUTH. TO CONST. ~~Existing System Inspection~~ by: STEVE HEDRICK date 10-27-97

Installed by: Andy Daniels

~~Certificate of Completion~~ by: date

Operation Permit by: B. C. Moore date 11-12-97

HEALTH DEPT. COPY: WHITE INSPECTION COPY (FINAL): GREEN OWNER COPY (FINAL): YELLOW INSPECTION COPY (INITIAL): PINK OWNER COPY (INITIAL): GOLD