IREDELL COUNTY HEALTH DEPARTMENT

STATESVILLE 704-878-5305 MOORESVILLE 704-664-5281

IMPROVEMENT PERMIT / AUTHORIZATION TO CONSTRUCT / OPERATION PERMIT / EXISTING SYSTEM INSPECTION

PERMIT# 083888 PIN# 4728 14 4293 DATE 10-12-99

OWNER OR CONTRACTOR CARROLL EARNEST PHONE: Business Home 876-3781

ADDRESS 135 WOODSDALE DRIVE, STATESVILLE, NC 28625

LOCATION NC 115 N, TL PISGAH RD, TL TREEBARK, TL WOODSDALE, AT END ON RIGHT

SUBDIVISION TREEBARK BLOCK / SECTION LOT 27 LOT AREA 2.58 Acres SITE CLASS PS DESIGN FLOW 100 L.T.A.R. 0.30 GPD/FT²

Septic Tank: 1000 Gallons; STB 1012 Date 8-3-99

Pump Tank: Gallons; PT Date

Pump Make: Model Serial No.

Nitrification Field: No Fields 1 Square Feet 330 Linear Feet 110

No Lines THREE Trench Width 36" Max Trench Bottom Depth 36" Gravel Depth 12"

☑ New System ☐ Repair System Type: ☐ I. ☐ II. ☐ III. ☐ IV. ☐ V. ☐ VI.

System Description: CONVENTIONAL GRAVITY

Repair System Description: CONV. GRAVITY

Maintenance Agreement Required: ☐ Yes ☑ No

☐ House/Mod. Home ☐ Mobile Home ☑ Business ☐ Other

No. Bedrooms No. Bathrooms 1 No. Employees 1

☐ Slab ☐ Crawl Space ☐ Basement w/plumbing ☐ Basement wo/plumbing


Water Supply: ☑ Individual ☐ Public ☐ Community WELL

Comments/Conditions: INSTALL NEW DRAINLINES ON CONTOUR AS FLAGGED

SCALE: 1"=50'

Comments/Conditions SEPTIC TANK WITH RISERS INSTALLED USING "POLY LOK" FILTER

INITIAL SITE SKETCH

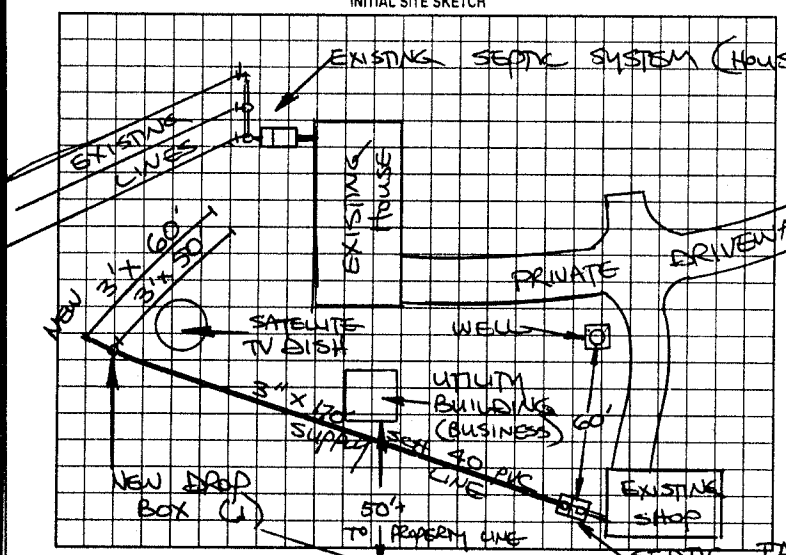

AS BUILT SKETCH

SYSTEM INSTALLED ACCORDING TO INITIAL SITE SKETCH

Permit can be suspended or revoked if any false information is supplied toward securing the permit/any unauthorized changes are made to the site/any unauthorized changes are made in the installation of the system. Improvement Permit with plat valid without expiration. Improvement Permit with site plan valid for sixty months. Authorization to Construct is valid for a period equal to that of Improvement Permit – not to exceed sixty months.

Signed: + Carroll Earnest date 10-12-99 Installed by: KENNY MADISON

Improvement Permit by: STEVE HEDRICK date 10-12-99 Operation Permit by: STEVE HEDRICK date 10-19-99

Authorization to Construct by: STEVE HEDRICK date 10-12-99 Existing System Inspection by: date

HEALTH DEPT COPY WHITE OWNER COPY (FINAL) YELLOW OWNER COPY (INITIAL) PINK