This Permit Voids permit issued 11-15-11

IREDELL COUNTY HEALTH DEPARTMENT - *ENVIRONMENTAL HEALTH* ☒ STATESVILLE OFFICE 704-878-5305 ☐ MOORESVILLE OFFICE 704-664-5281

IMPROVEMENT PERMIT / AUTHORIZATION TO CONSTRUCT / OPERATION PERMIT / EXISTING SYSTEM INSPECTION

PERMIT # 1607928 PIN # ~~4728-15-7740~~ 4728-15-5764 DATE 4-2-12

OWNER Hunt Family Trust APPLICANT: Michelle Dagenhart PHONE: Home/Cell # 704 880 2853 Business #

SITE ADDRESS 123 Pisgah Church Rd. OWNER / APPLICANT ADDRESS

SITE DIRECTIONS Hwy 115 N (L) Pisgah Rd. Church Rd., Statesville, NC

SUBDIVISION n/a BLOCK / SECTION n/a LOT # n/a LOT AREA .661 AC DESIGN FLOW 480 gpd L.T.A.R. .3

Septic Tank 1000 Gallons: STB 1017 Date 10-14-11

Pump Tank Gallons: P T Date

Pump Make Model Serial #

No. Nitrification Fields: 1 No. Lines 5 Linear Feet 400

Trench Width 36" Max. Trench Bottom Depth 28" Gravel Depth n/a

☒ New System ☐ Repair ☐ Expansion System Type I II (III) IV V VI

System Description: 25% Reduction System

Repair System Description: 50 LF Pressure

Maintenance Agreement Required ☐ YES ☒ NO

☒ GRAVITY ☐ PRESSURE

☒ Residence No. Bedrooms 4

☐ Business No. Persons

☐ Other No. Employees


☐ Slab ☒ Crawl Space

☐ Basement w/plumbing ☐ Basement w/o plumbing

Water Supply: ☒ Private ☐ Public ☐ Community

Comments / Conditions

INITIAL SITE SKETCH

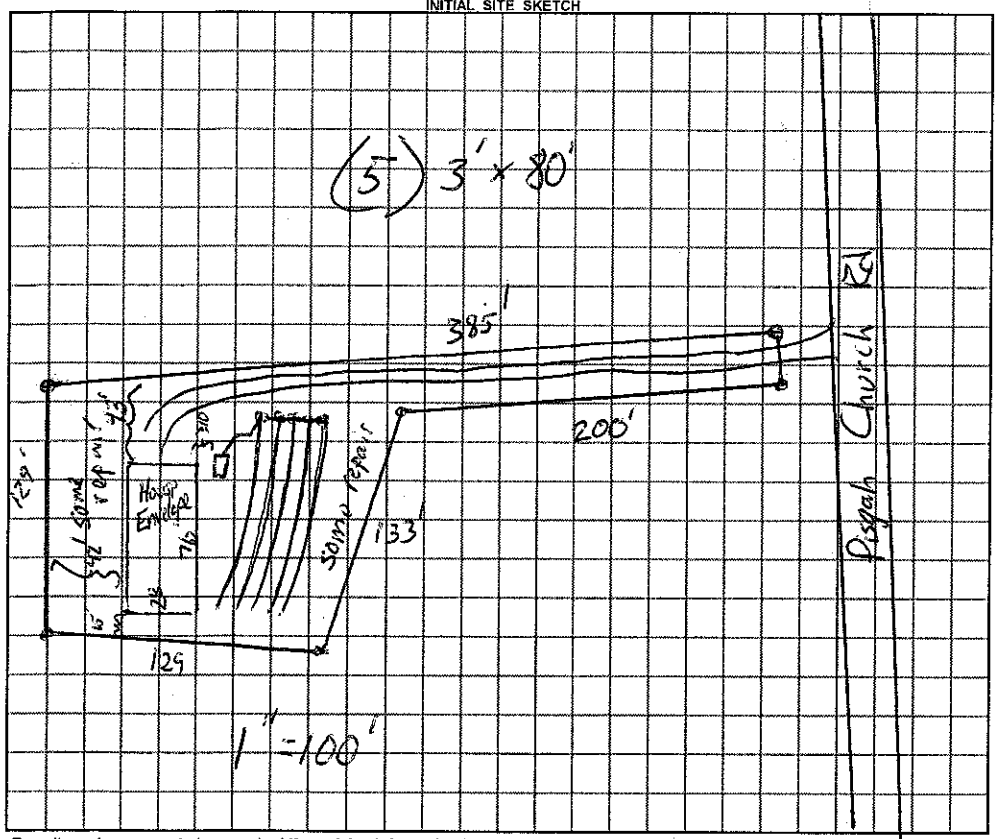

AS BUILT SKETCH

Permit can be suspended or revoked if any false information is supplied toward securing the permit / any unauthorized changes are made to the site / any unauthorized changes are made in the installation of the system.

☐ ***IMPROVEMENT PERMIT*** with plat valid without expiration. ☐ ***IMPROVEMENT PERMIT*** with plat valid without expiration, site plan valid 60 mo. ☐ ***AUTHORIZATION TO CONSTRUCT*** valid for period equal to IMPROVEMENT PERMIT--not to exceed 60 mo.

Owner / Applicant Signature: Debra Alee Date 4/4/12 Installed by: Ground Breakers

IMPROVEMENT PERMIT by: REHS Date 4-4-12 OPERATION PERMIT by: REHS Date 4-10-12

AUTHORIZATION TO CONSTRUCT by: REHS Date 4-4-12 Existing System Inspected by: REHS Date

YOU SHOULD CONTACT A LOCATOR SERVICE PRIOR TO ANY EXCAVATION

White Copy – Environmental Health YELLOW COPY (Final) Owner / Applicant PINK COPY (Initial) Owner / Applicant