IREDELL COUNTY HEALTH DEPARTMENT

Statesville Phone TR 3-7271 Mooresville Phone NO 3-1271

PERMIT TO INSTALL SEPTIC TANK

Permit No. _____ Permit Date 6-26 1964

Owner DON HAGER Address R.F.D. STA.

Installed By BILL MARTIN Address STA.


Location of Property NP #115 CROSS RIDER AT INTERSECTION OF PISGAH CH. ROAD #115 - 6N LEFT - BRICK

Tank		Capacity		Length of Lines		Fixtures	
Block	( )	1000	(✓)	225'	(✓)	No. of Baths	(1½)
Precast	(✓)	1250	( )	250'	( )	Dishwasher	( )
		1500	( )	Other _____		Garbage Grdr.	( )
		Other _____				Other _____	

NOTIFY HEALTH DEPARTMENT AT LEAST EIGHT HOURS BEFORE TANK IS TO BE INSPECTED.

Final Inspection 6-26 1964 Approved (✓) Disapproved ( )

Remarks WELL ON ADJOINING PROPERTY

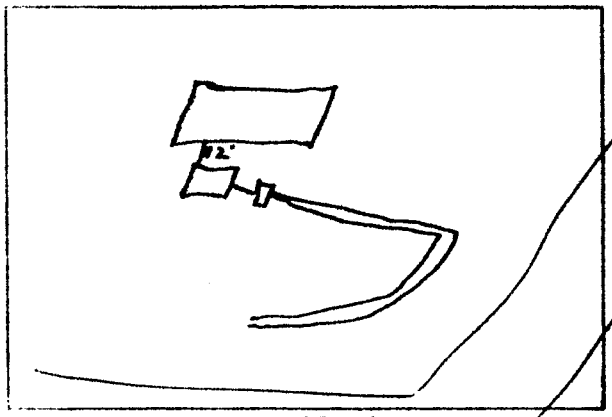

Sketch of Installation

Rafael C Thomas Jr.

Sanitarian