ICHD - ENVIRONMENTAL HEALTH DIVISION

Statesville Office (704) 878-5305 Mooresville Office (704) 660-3625

PERMIT # OSWP-2022-7896

SEPTIC: IMPROVEMENT PERMIT / AUTHORIZATION TO CONSTRUCT / OPERATION PERMIT / EXISTING SYSTEM

PIN # 4728 -- 20 -- 0339

APPLICANT/OWNER: RICKY & DEBORAH HARRIS

APPLICANT ADDRESS: 220 RIVERSIDE ROAD, STATESVILLE, N.C. 28625

SITE ADDRESS: 220 RIVER SIDE ROAD, STATESVILLE, N.C. 28625

PHONE: 704-397-6238

ALT. PHONE —

SITE DIRECTIONS: (N) ON 115, (L) ON RIVERSIDE, LOT (@) END

SAP CONTROLLED: ☐ YES ☐ NO EXT

SUBDIVISION: —

SECTION: — LOT # — LOT AREA: 12.63 AC


DESIGN FLOW: EXT L.T.A.R.: EXT

Septic Tank	1000	(gal)	STB 1012	Date	10-3-2022	☐ New System	☑ Repair	☐ Expansion	System Type: I (II) III IV V VI
Pump Tank	—	(gal)	PT —	Date	—	System Description:	EXISTING		
Pump Make	—	Model	—	Serial #	—	Repair System Description:	TANK REPLACEMENT		
# Nitrification Fields	EXT	# Lines	EXT	Linear Ft	EXT	Maintenance Agreement Required:	☐ YES	☑ NO	
Trench Width	EXT	Trench Bottom Depth(Low side)	EXT	Gravel Depth	EXT		☑ GRAVITY	☐ PRESSURE	

☑ Residence	No. Bedrooms	EXT	Water Supply
☐ Business	No. Persons	EXT	☑ Private EXT
☐ Other	No. Employees	—	☐ Public
☐ Slab	☑ Crawl Space		☐ Community
☐ Basement w/plumbing			☑ Basement w/o plumbing


Comments / Conditions: DRAINFIELD WAS SATURATED AT TIME OF INSPECTION BUT APPEARED TO BE FUNCTIONING, PUMP, CRUSH, AND FILL EXISTING SEPTIC TANK, REPLACE D-BOX, LEAKING TOILET MUST BE FIXED

INITIAL SITE SKETCH

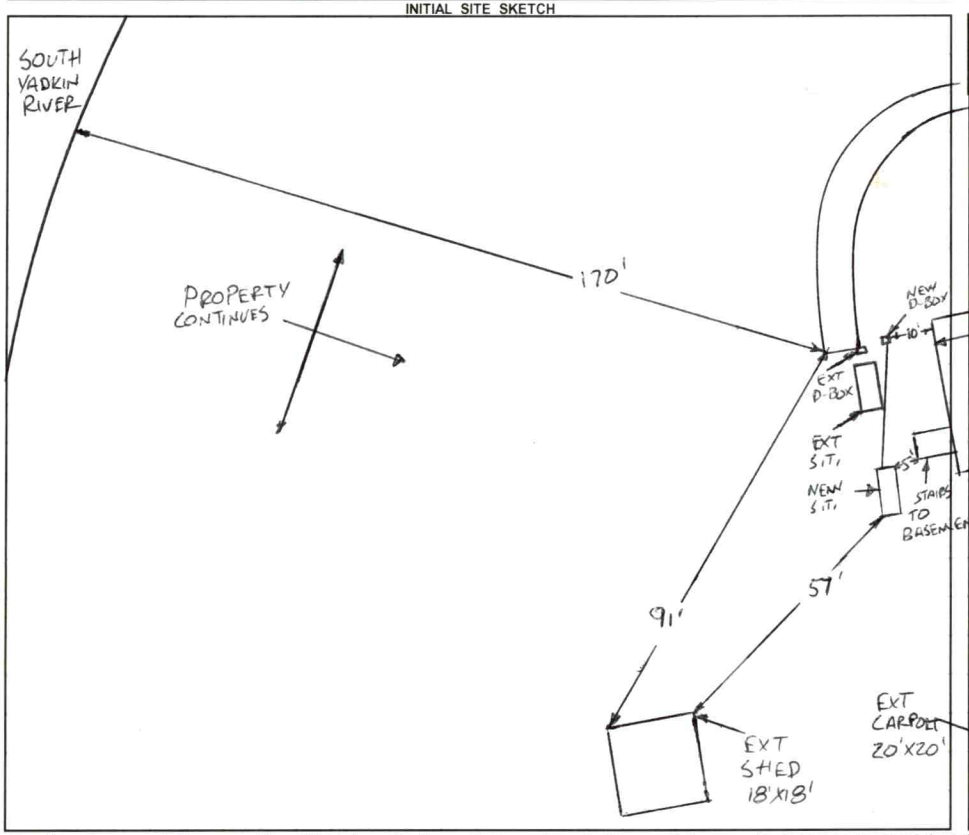

AS BUILT SKETCH

FOR SEPTIC FINAL INSPECTION CALL: 704-664-3703 between 8am-9am the day the inspection is needed. Be sure to speak with an inspector to confirm your time.

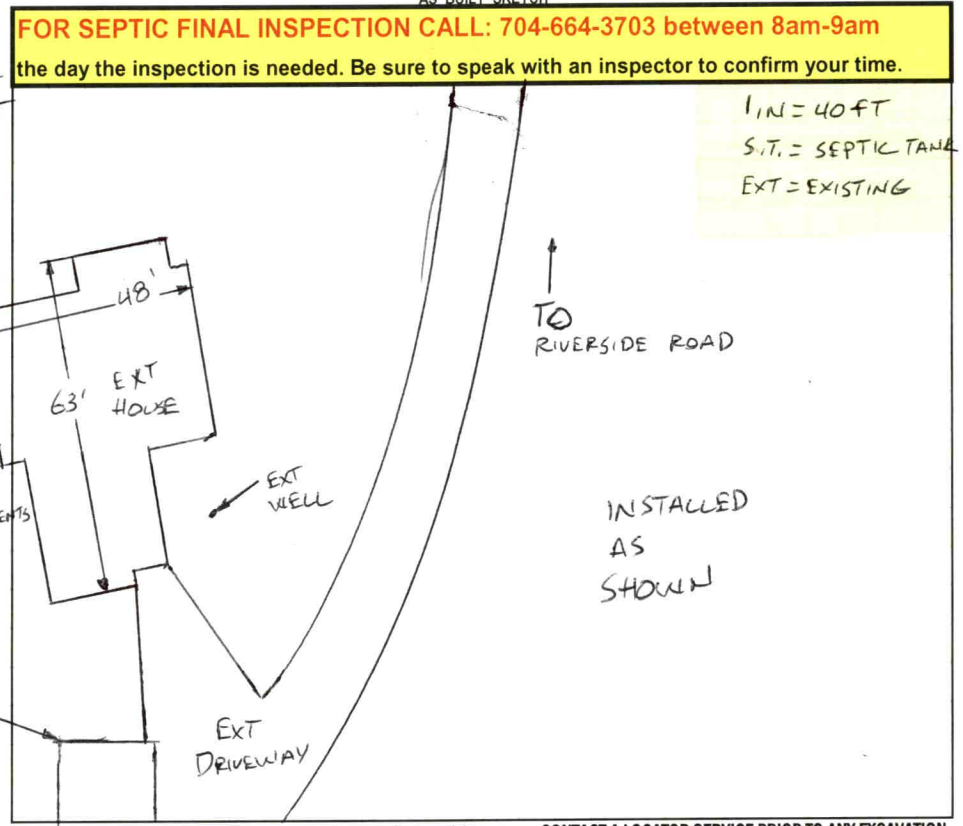

Permit can be suspended or revoked if any false information is supplied toward securing the permit / any unauthorized changes are made to the site / any unauthorized changes are made in the installation of the system. **CONTACT A LOCATOR SERVICE PRIOR TO ANY EXCAVATION**

☐ **IMPROVEMENT PERMIT** ***with plat*** *valid without expiration.* ☑ **IMPROVEMENT PERMIT** ***with site plan*** *valid for 60 mos.* ☑ **AUTHORIZATION TO CONSTRUCT** *valid for period equal to IMPROVEMENT PERMIT--not to exceed 60 mo.*

Owner / Applicant Signature: _____ Date: _____ Installed by: STEVE JORDAN

IMPROVEMENT PERMIT by: Bryant C. White Date: 1-10-2023 OPERATION PERMIT by: Bryant C. White Date: 1-11-2022

AUTHORIZATION TO CONSTRUCT by: Bryant C. White Date: 1-10-2023 Existing System Inspected by: _____ Date: _____

FOR SEPTIC FINAL INSPECTION: CALL 704-664-3703 between 8am-9am the day the inspection is needed.

Item	Date	Initials
Drain Lines Checked		
Tanks Checked		
Pressure Manifold or Valve Box Checked		
Pressure Head Set		
Electrical Checked		
Floats Set		
Alarm Checked		
Maintenance Contract Needed? Y / N		
Comments:		

Repairs Only	
	State Code
Failing System Code	
Type of Distribution	G or P
Type of Failure/Malfunction	
Primary Cause of Failure/Malfunction	
Age of System? _____	
Initial or Repair? _____	

PERMIT SNAPSHOT REPORT OSWP-2022-7896
FOR IREDELL COUNTY

Permit Type	Environmental Health OSWP	**Project:**		**App Date:**	10/26/2022
Work Class:	EH Septic Improvement Permit Repair	**District:**	Iredell County	**Exp Date:**	NOT AVAILABLE
Status:	PRIORITY PERMIT	**Square Feet:**	0.00	**Completed:**	NOT COMPLETED
Valuation:	$0.00	**Assigned To:**	White, Bryant	**Approval Expire Date:**	

Description: repair septic - Tail line is stopped up and tank is old when backs up it surfaces to top of ground - coming up near tank

Parcel: 4728200339.000 Main	**Address:** 220 Riverside Rd Statesville, NC 28625 Main	**Zone:** RA(Residential Agricultural District)

Property Owner
DEBORAH L B+RICKY HARRIS

Applicant/Authorized Agent
Ricky Harris
220 Riverside Rd
Statesville, NC 28625
704-397-6238

Permit Custom Fields

How is your site plan being submitted	Custom Site Plan	Does the site contain any jurisdictional wetlands	No	Non-domestic Sewage Generated	No
Other Public Agency	No	Maximum Number of Bedrooms	5	Number of Occupants	2
Foundation Type	Basement with Plumbing	Water Supply	Existing Well	Desired Septic System Type	Conventional (most common)
If other septic system type, please explain		Additional Unique Setbacks Apply	No		

Attachment File Name	Added On	Added By	Attachment Group	Notes
Signature_Ricky_Harris_10/26/2022.jpg	10/26/2022 11:09	Harris, Ricky		Uploaded via CSS
220 Riverside owner auth_v1.pdf	11/01/2022 8:39	Hart, Ronda	Available Online	Authorize to Act as Agent
220 Riverside site plan_v1.pdf	11/01/2022 8:39	Hart, Ronda	Available Online	Site Plan

Invoice No.	Fee	Fee Amount	Amount Paid
NOT INVOICED	Existing System Septic Repair Permit	$150.00	$0.00
	Total for Invoice NOT INVOICED	$150.00	$0.00
	Grand Total for Permit	**$150.00**	**$0.00**


Workflow Step / Action Name	Action Type	Start Date	End Date
Application Completeness Check v.1		11/01/2022 0:00	11/01/2022 8:39
Confirm application complete v.1	Generic Action		11/01/2022 8:39
~~**Zoning Review v.1**~~			11/01/2022 8:40
~~Iredell County Zoning Approval v.1~~	Task		11/01/2022 8:40
~~Issue Invoice v.1~~	Generic Action		11/01/2022 8:40
~~Fees Paid v.1~~	Generic Action		11/01/2022 8:40
Lot Readiness Verification v.1			
~~OSWP Septic Preliminary Site Visit v.1~~	Inspection		11/01/2022 8:41
OSWP Site Evaluation v.1	Inspection		
Assign v.1			
Case Assigned v.1	Generic Action		
Permit Ready v.1			
Issue Permit v.1			
Issue Invoice v.1	Generic Action		
Fees Paid v.1	Generic Action		
Issue Permit v.1	Generic Action		

PERMIT SNAPSHOT REPORT (OSWP-2022-7896)

Environment Health Inspections v.1

Operation Permit Inspection v.1 Inspection

220 Riverside site plan

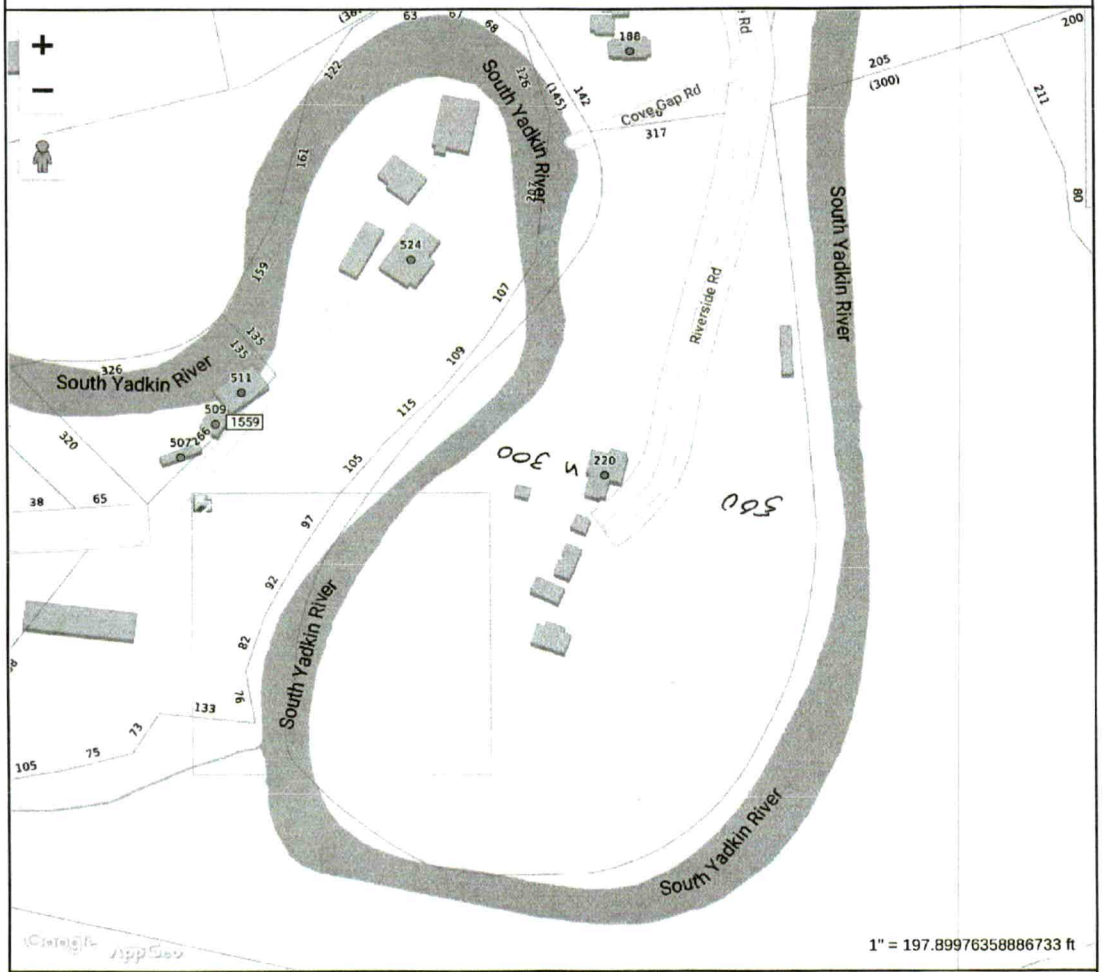


IREDELL COUNTY NC

MAP FOR REFERENCE ONLY
NOT A LEGAL DOCUMENT

Iredell County, North Carolina makes no claims and no warranties, expressed or implied, concerning the validity or accuracy of the GIS data presented on this map.

Print map scale is approximate. Critical layout or measurement activities should not be done using this resource.

EXT DRAIN FIELD
D-BOX
EXT ST.
6'
4'
EXT WELL

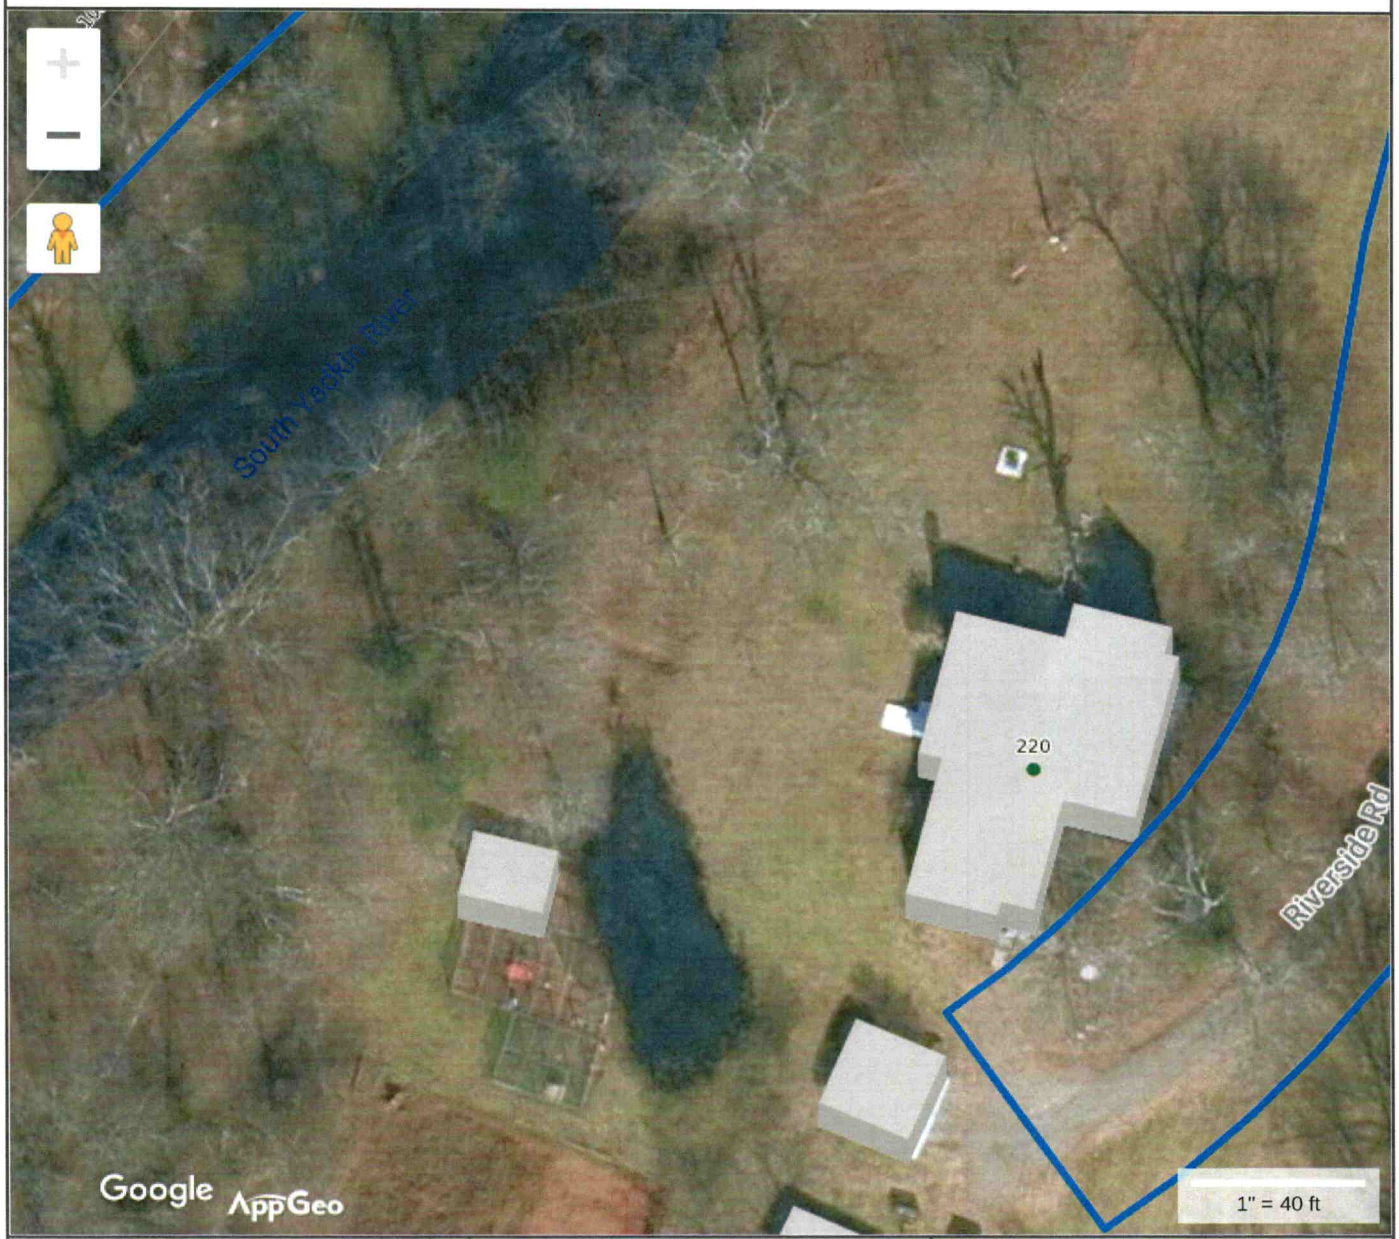

Tax Map Information

• PIN	4728200339.000
• Address	220 RIVERSIDE RD
• Account #	Acct 77422542
• Tax Owner	HARRIS DEBORAH LEE B
• Mailing Address	220 RIVERSIDE RD
•	STATESVILLE, NC 28625
• GIS Owner	HARRIS DEBORAH L B+RICKY
• Deed Info	1386 / 953 - WD - 20021113
• Tax Acres	12.63 AC
• Lot #	
• Description	HAGER SR1557 OFF
• Zoning	RA
• Old Parcel #	0914B00000A042
• Bldg Value	$44,990
• OBXF Value	$6,980
• Land Value	$42,440
• Total Value	$94,410
• Defer Value	$0
• Tax Districts	-ALLCNTY FIRE- -

IREDELL COUNTY NC

MAP FOR REFERENCE ONLY
NOT A LEGAL DOCUMENT

Iredell County, North Carolina makes no claims and no warranties, expressed or implied, concerning the validity or accuracy of the GIS data presented on this map.

Print map scale is approximate. Critical layout or measurement activities should not be done using this resource.