IREDELL COUNTY HEALTH DEPARTMENT

STATESVILLE 704-878-5305 MOORESVILLE 704-664-5281

IMPROVEMENT PERMIT / AUTHORIZATION TO CONSTRUCT / OPERATION PERMIT / EXISTING SYSTEM INSPECTION

PERMIT# _____ PIN# _____ DATE 7-28-00

OWNER OR CONTRACTOR Michael Johnson PHONE: Business Cell 437 2856 Home 876 1897

ADDRESS 3345 Wilkesboro Hwy Statesville NC.

LOCATION 115 W past S. Yadkin 7th HSC left.

SUBDIVISION _____ BLOCK / SECTION _____ LOT _____ LOT AREA 3 1/2 acres SITE CLASS. PS DESIGN FLOW 240 L.T.A.R. .4

Septic Tank: 1000 Gallons; STB _____ Date _____

Pump Tank: _____ Gallons; PT _____ Date _____

Pump Make: _____ Model _____ Serial No. _____

Nitrification Field: No Fields 1 Square Feet 750 Linear Feet 250

No Lines 2 Trench Width 72" Max Trench Bottom Depth 36" Gravel Depth 12"

~~New~~ System (✓ Repair) System Type: I (II) III. IV. V. VI

System Description: _____

Repair System Description: Conv. Gravity

Maintenance Agreement Required: ☐ Yes ☐ No

(✓ House/Mod Home) No. Bedrooms 2

☐ Mobile Home No. Bathrooms 1

☐ Business No. Employees _____

☐ Other _____


☐ Slab ☐ Crawl Space ☐ Basement w/plumbing ☐ Basement wo/plumbing

Water Supply: (✓ Individual) ☐ Public ☐ Community

Comments/Conditions:

Comments/Conditions.

INITIAL SITE SKETCH

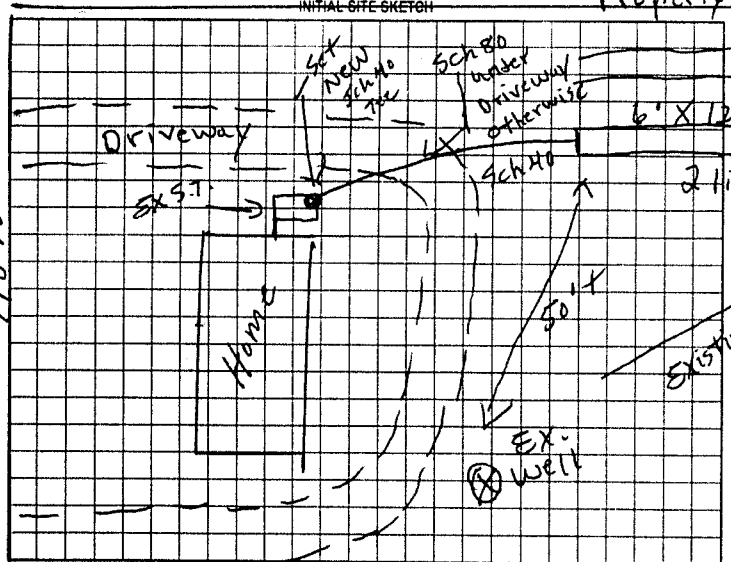

AS BUILT SKETCH

SYSTEM REPAIRED ACCORDING TO INITIAL SITE SKETCH

Permit can be suspended or revoked if any false information is supplied toward securing the permit/any unauthorized changes are made to the site/any unauthorized changes are made in the installation of the system. Improvement Permit with plat valid without expiration. Improvement Permit with site plan valid for sixty months. Authorization to Construct is valid for a period equal to that of Improvement Permit – not to exceed sixty months.

Signed: X - Michael J. Johnson date _____ Installed by: SKIP PECKHAM

Improvement Permit by: P.C. Moore date 7-28-00 Operation Permit by: STEVE HENDRICK date 9-7-00

Authorization to Construct by: P.C. Moore date 7-28-00 Existing System Inspection by: _____ date _____

HEALTH DEPT. COPY. WHITE OWNER COPY (FINAL). YELLOW OWNER COPY (INITIAL). PINK